IREDELL COUNTY HEALTH DEPARTMENT

Statesville Office (704) 878-5305 Mooresville Office (704) 660-3625 PERMIT # 152574

IMPROVEMENT PERMIT / AUTHORIZATION TO CONSTRUCT / OPERATION PERMIT / EXISTING SYSTEM

PIN # 4649-04-0257

APPLICANT: Meritage Homes of NC APPLICANT ADDRESS: 7761 Ballantyne Commons Parkway Suite Charlotte NC

SITE ADDRESS: 112 San Agustin Dr Mooresville PHONE: 704-944-8900 ALT. PHONE:

SITE DIRECTIONS: Hwy 150 W, TR on Perth Rd, TL on Bells Crossing, TL on S. San Agustin Dr, Lot on R

SUBDIVISION: Bells Crossing SECTION: LOT # 105 LOT AREA: 0.9 ac DESIGN FLOW: 600gpd L.T.A.R.: 0.3

Septic Tank 1250 (gal)	STB	Date	☑ New System ☐ Repair ☐ Expansion System Type: I II III IV V VI	☑ Residence	No. Bedrooms 5	Water Supply
Pump Tank (gal)	PT	Date	System Description: Gravity 25% Reduction	☐ Business	No. Persons 10	☐ Private
Pump Make	Model	Serial #	Repair System Description: Gravity 25% Reduction	☐ Other	No. Employees	☐ Public
# Nitrification Fields 1	# Lines 4	Linear Ft: 508	Maintenance Agreement Required: ☐ YES ☑ NO	☑ Slab	☐ Crawl Space	☑ Community
Trench Width 36"	Max. Trench Bottom Depth 36"	Gravel Depth N/A	☑ GRAVITY ☐ PRESSURE	☐ Basement w/plumbing	☐ Basement w/o plumbing	

Comments / Conditions:


INITIAL SITE SKETCH

SEE DESIGN BY BATEMAN CIVIL SURVEY COMPANY

SEE REVISED SITE PLAN DATED 9-29-14 Approved 10-1-14 RP

APPROVED BY ICHD

AS BUILT SKETCH

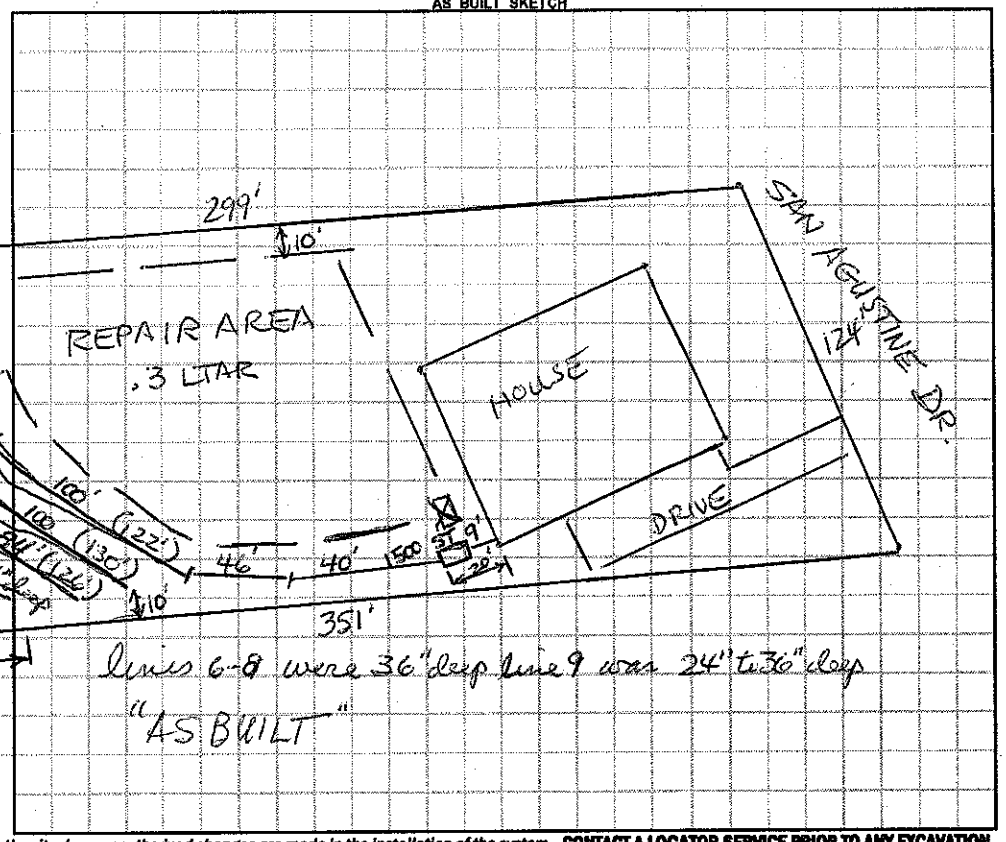

Permit can be suspended or revoked if any false information is supplied toward securing the permit / any unauthorized changes are made to the site / any unauthorized changes are made in the installation of the system. **CONTACT A LOCATOR SERVICE PRIOR TO ANY EXCAVATION**

☐ **IMPROVEMENT PERMIT** *with plat valid without expiration.* ☑ **IMPROVEMENT PERMIT** *with site plan valid for 60 mos.* ☐ **AUTHORIZATION TO CONSTRUCT** *valid for period equal to IMPROVEMENT PERMIT--not to exceed 60 mo.*

Owner / Applicant Signature: Date: 1-30-14 Installed by: Carolina Pipe

IMPROVEMENT PERMIT by: Date: 1-29-14 OPERATION PERMIT by: Richard Farris Date: 10/22/14

AUTHORIZATION TO CONSTRUCT by: APPROVED JUN 10 2014 Date: Existing System Inspected by: Date:

Health Dept. Copy - WHITE Applicant (Final Approval) - YELLOW Applicant (Conditional Approval) - PINK