IREDELL COUNTY HEALTH DEPARTMENT

Statesville Office (704) 878-5305 Mooresville Office (704) 660-3625

4649043350

PERMIT # 152401

IMPROVEMENT PERMIT / AUTHORIZATION TO CONSTRUCT / OPERATION PERMIT / EXISTING SYSTEM

PIN # 508

APPLICANT: MERITAGE HOMES APPLICANT ADDRESS: 7781 BALLANTYNE COMMONS PKWY

SITE ADDRESS: PHONE: 704-309-6577 ALT. PHONE:

SITE DIRECTIONS: PERTH, TL BELLS CROSSING, TL SAN AUGUSTIN, ON L

SUBDIVISION: BELLS CROSSING SECTION: LOT # 12 LOT AREA: .57 AC DESIGN FLOW: 480 L.T.A.R.: .3

Septic Tank 1600 (gal) STB: 1.60 Date 4-3-13
Pump Tank 1000 (gal) PT 363 Date 7-7-13
Pump Make Model Serial #
Nitrification Fields 1 # Lines 5 Linear Ft: 413'
Trench Width 36" Max. Trench Bottom Depth 36" Gravel Depth

☒ New System ☐ Repair ☐ Expansion System Type: I II III-B IV V VI
System Description: PM 25% REDUCTION
Repair System Description: PANEL BLOCK
Maintenance Agreement Required: ☐ YES ☒ NO ☐ GRAVITY ☒ PRESSURE


☒ Residence No. Bedrooms 4
☐ Business No. Persons
☐ Other No. Employees
☒ Slab ☐ Crawl Space
☐ Basement w/plumbing ☐ Basement w/o plumbing

Water Supply: ☐ Private ☐ Public ☒ Community

Comments / Conditions:

(704) 797-1657 (BRIAN)
Checked Tanks, Drainlines on 9/19/13 (m)
CHECKED PM 9-26-13 BA

INITIAL SITE SKETCH

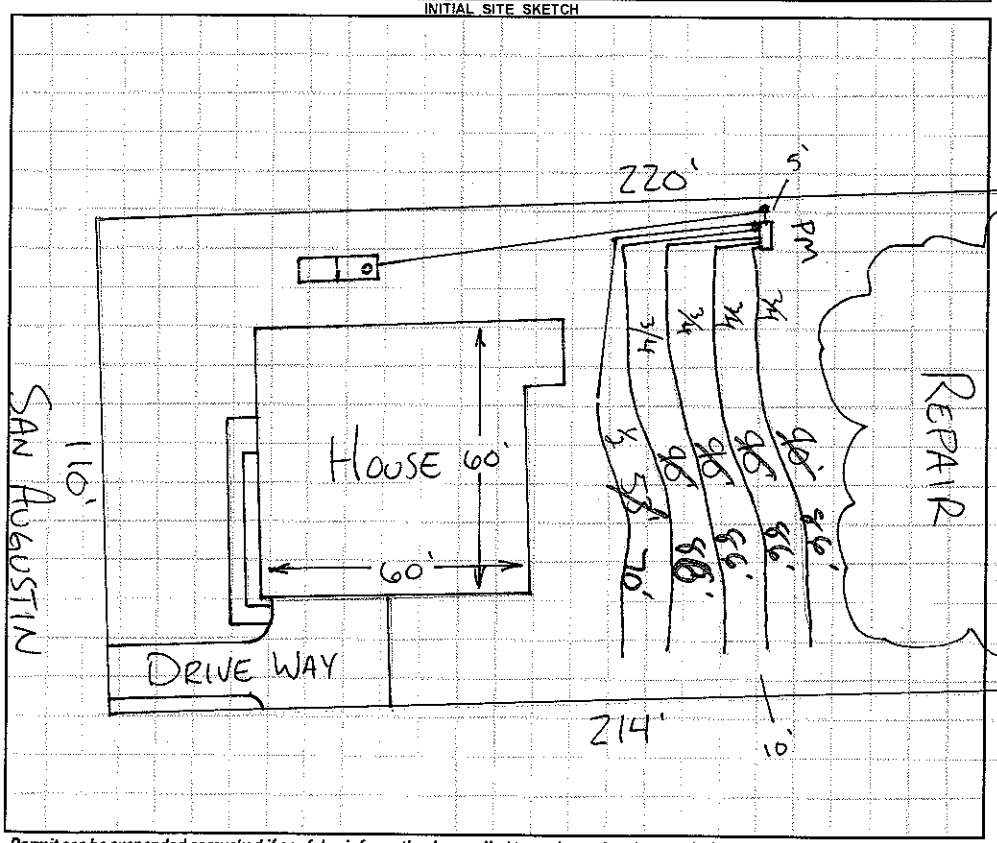

AS BUILT SKETCH

TAP SIZES

4 @ 90' - 3/4 (80) - (1/2" sch 80, 1/2 sch 40)

53' - 1/2 80 -

CHECKED PM

CHECKED ELECTRICAL BA 12-18-13

Permit can be suspended or revoked if any false information is supplied toward securing the permit / any unauthorized changes are made to the site / any unauthorized changes are made in the installation of the system. **CONTACT A LOCATOR SERVICE PRIOR TO ANY EXCAVATION**

☐ **IMPROVEMENT PERMIT** *with plat valid without expiration.* ☒ **IMPROVEMENT PERMIT** *with site plan valid for 60 mos.* ☐ **AUTHORIZATION TO CONSTRUCT** *valid for period equal to IMPROVEMENT PERMIT--not to exceed 60 mo.*

Owner / Applicant Signature: Date: 6/18/13 Installed by: Brian Hurst / Carolina Pipe

IMPROVEMENT PERMIT by: BA Date: 6-13-13 OPERATION PERMIT by: BA Date: 12-18-13

AUTHORIZATION TO CONSTRUCT by: Date: 6-18-13 Existing System Inspected by: Date:

Health Dept. Copy - WHITE Applicant (Final Approval) - YELLOW Applicant (Conditional Approval) - PINK