IREDELL COUNTY HEALTH DEPARTMENT

STATESVILLE 704-878-5305 /30.00 Paid MOORESVILLE 704-664-5281

IMPROVEMENT PERMIT / AUTHORIZATION TO CONSTRUCT / OPERATION PERMIT / EXISTING SYSTEM INSPECTI

PERMIT# 112930 PIN# 4649 05 5641.18 4649-04-4781 DATE 9/19/03

OWNER OR CONTRACTOR CORINTHEAN DEVELOPERS PHONE: Business 887-9697 Home

ADDRESS PO BOX 990 DENVER NC 28037

LOCATION PERTH (N) - TR GRAYCLIFF - ON RT NEAR END

SUBDIVISION GRAYCLIFF BLOCK / SECTION LOT 18 LOT AREA SITE CLASS. PS DESIGN FLOW 360GPD L.T.A.R. .3050 Acre

Septic Tank: 1000 Gallons; STB 786 Date 9/27/03
Pump Tank: 1000 Gallons; PT 440 Date 8/21/03
Pump Make: Myers Model SRN4 Serial No.
Nitrification Field: No Fields 4 Square Feet 900 Linear Feet 360
No Lines 3@100' Trench Width 36" Max Trench Bottom Depth 36" Gravel Depth NA

☑ New System ☐ Repair System Type: I, II, (III), IV, V, VI
System Description: PUMP 25% REDUCTION
Repair System Description: LO PANEL
Maintenance Agreement Required: ☐ Yes ☑ No

☑ House/Mod. Home No. Bedrooms 3
☐ Mobile Home No. Bathrooms 3
☐ Business No. Employees
☐ Other


☐ Slab ☐ Crawl Space ☑ Basement w/plumbing ☐ Basement wo/plumbing

Water Supply: ☑ Individual ☐ Public ☐ Community

Comments:/Conditions:


1"=50'

INITIAL SITE SKETCH

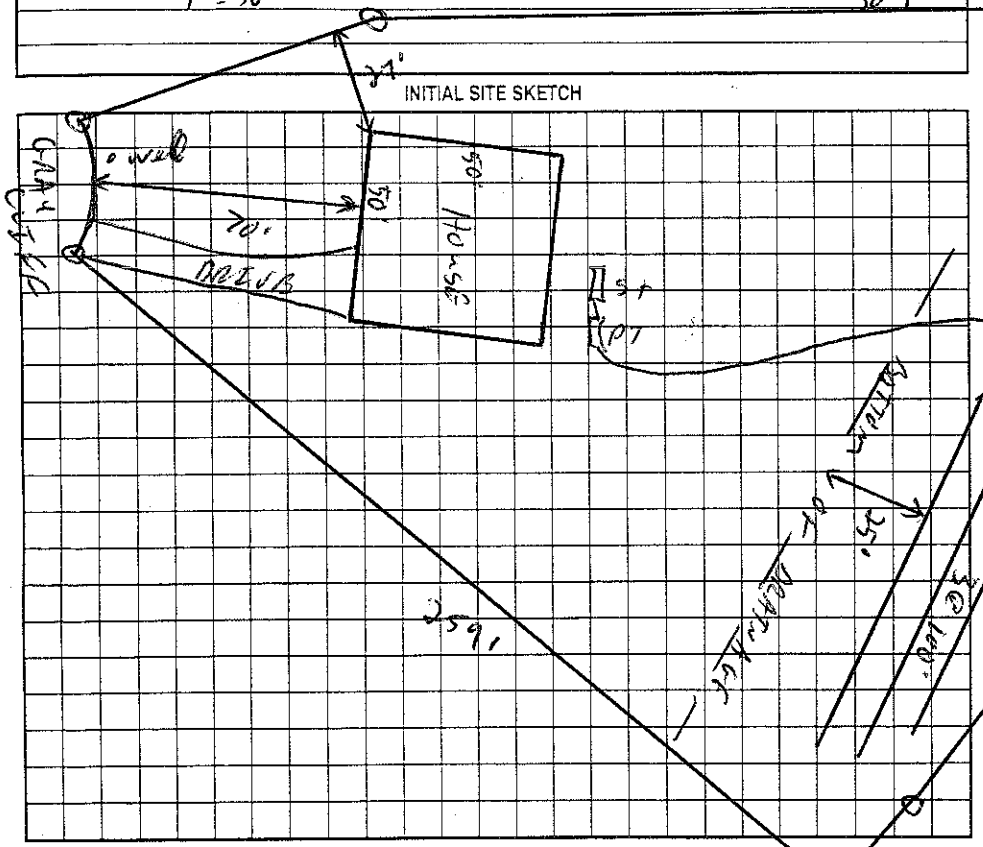

Comments:/Conditions:

AS BUILT SKETCH

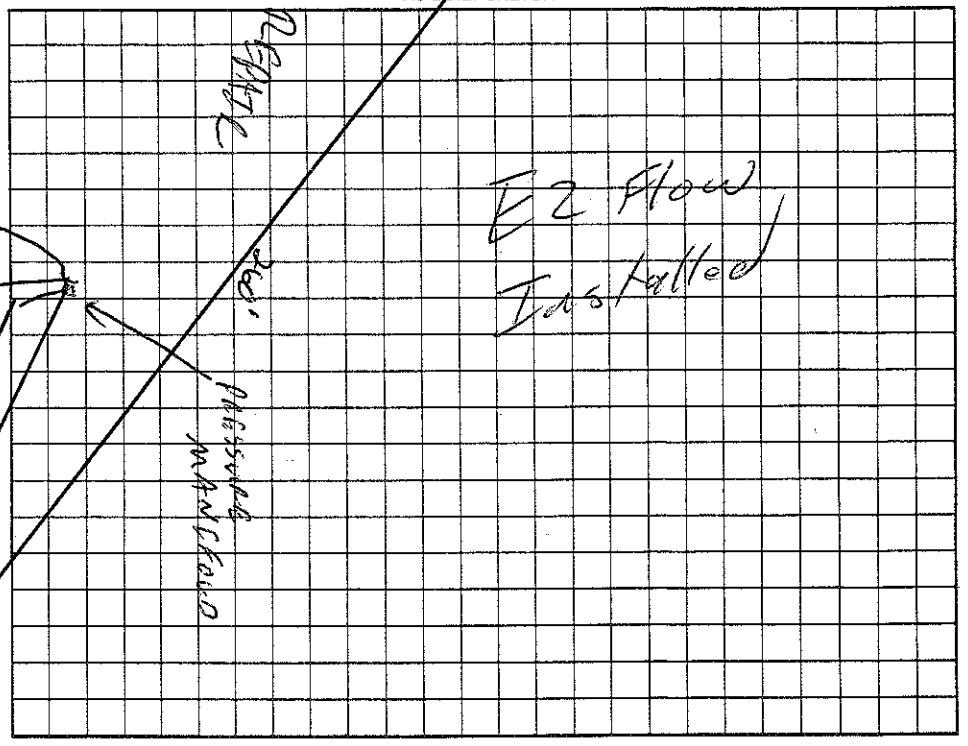

Permit can be suspended or revoked if any false information is supplied toward securing the permit/any unauthorized changes are made to the site/any unauthorized changes are made in the installation of the system. Improvement Permit with plat valid without expiration. Improvement Permit with site plan valid for sixty months. Authorization to Construct is valid for a period equal to that of Improvement Permit – not to exceed sixty months.

Signed: [signature] date 9/24/03 Installed by: Corinthian Bldrs

Improvement Permit by: [signature] RS date 9/19/03 Operation Permit by: [signature] RS date 3/29/04

Authorization to Construct by: [signature] RS date 9/24/03 Existing System Inspection by: date

HEALTH DEPT. COPY: WHITE OWNER COPY (FINAL): YELLOW OWNER COPY (INITIAL): PINK