IREDELL COUNTY HEALTH DEPARTMENT

STATESVILLE 704-878-5305 MOORESVILLE 704-664-5281

$1 130

IMPROVEMENT PERMIT / AUTHORIZATION TO CONSTRUCT / OPERATION PERMIT / EXISTING SYSTEM INSPECTION

PERMIT# 12921 PIN# 4649 05 56 41.16 4649-64-7836 DATE 9/19/03

OWNER OR CONTRACTOR CORINTHIAN DEVELOPERS LTD PHONE: Business 827-9697 Home

ADDRESS PO BOX 990 DENVER NC 28037

LOCATION PERTH (N) - TR GRAYCLIFF AT END OF LT

SUBDIVISION GRAYCLIFF BLOCK / SECTION LOT 16 LOT AREA . SITE CLASS. PS DESIGN FLOW 360GPD L.T.A.R. .3680/1852

Septic Tank: 1000 Gallons; STB 786 Date 9/16/03

Pump Tank: 1000 Gallons; PT 40 Date 10/6/03

Pump Make: Myers Model ME100 Serial No.

Nitrification Field: No Fields 1 Square Feet 900 Linear Feet 300

No Lines 4 Trench Width 36" Max Trench Bottom Depth 36" Gravel Depth N/A

☑ New System ☐ Repair System Type: I, II, (III), IV, V, VI

System Description: PUMP 25% REDUCTION

Repair System Description: LP PANEL

Maintenance Agreement Required: ☐ Yes ☒ No

☐ House/Mod. Home No. Bedrooms 3

☐ Mobile Home No. Bathrooms 3

☐ Business No. Employees

☐ Other

☐ Slab ☑ Crawl Space ☐ Basement w/plumbing ☐ Basement wo/plumbing


Water Supply: ☒ Individual ☐ Public ☐ Community

Comments:/Conditions:


Comments:/Conditions: EZFLOW INSTALLED

11/26/03 - DRAINFIELD, THANKS

1" = 50' INITIAL SITE SKETCH

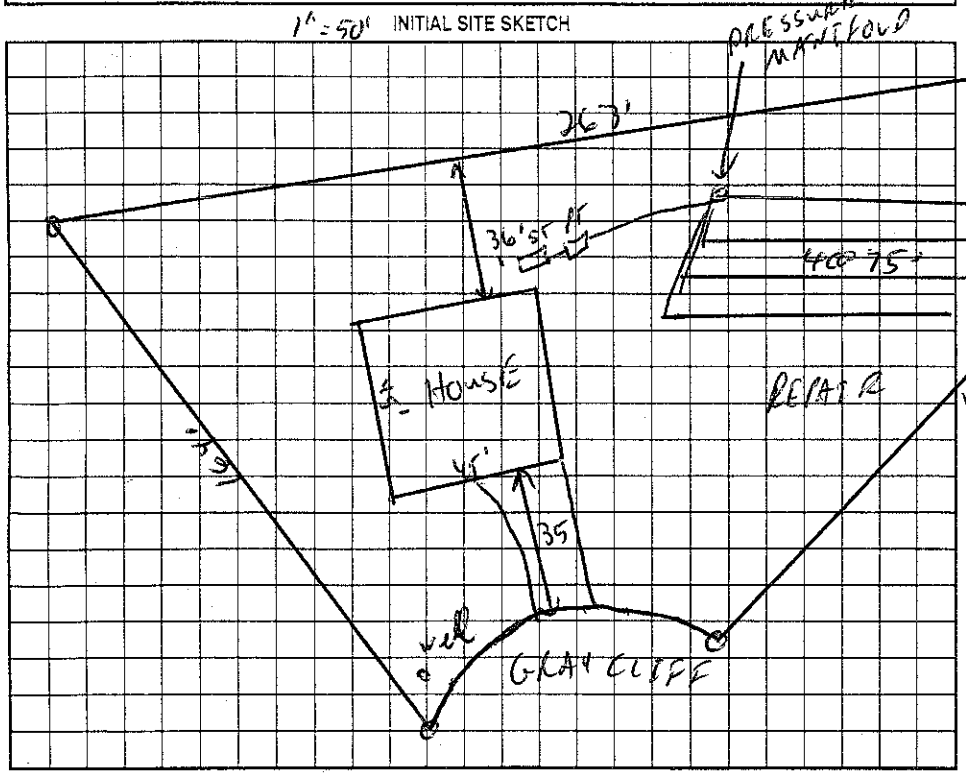

AS BUILT SKETCH

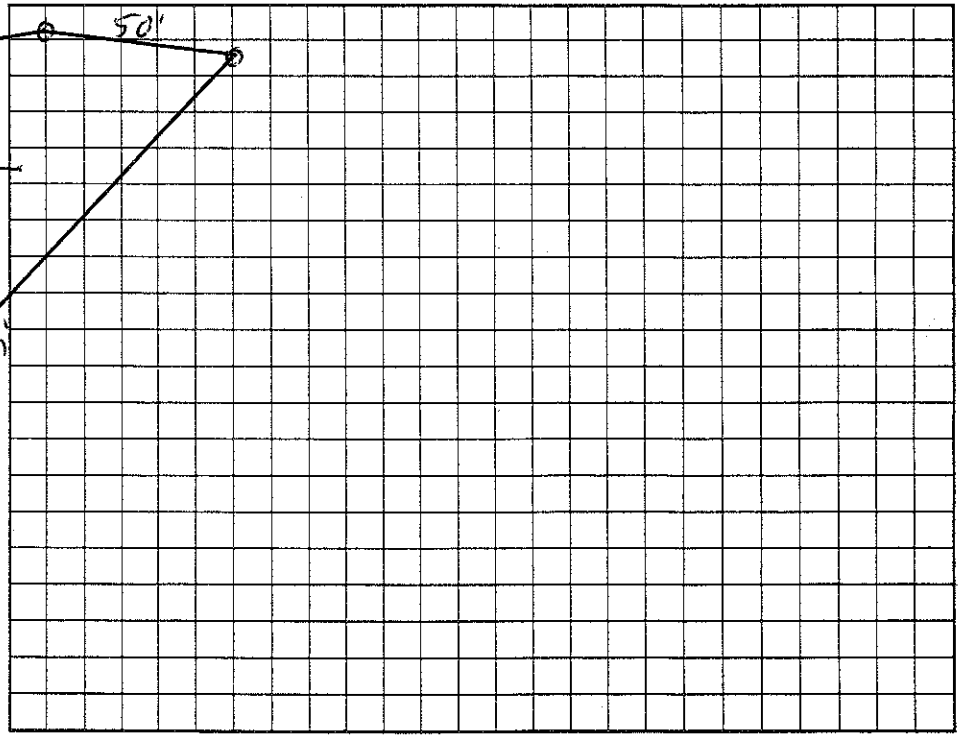

Permit can be suspended or revoked if any false information is supplied toward securing the permit/any unauthorized changes are made to the site/any unauthorized changes are made in the installation of the system. Improvement Permit with plat valid without expiration. Improvement Permit with site plan valid for sixty months. Authorization to Construct is valid for a period equal to that of Improvement Permit – not to exceed sixty months.

Signed: date

Installed by: Corinthian Builders

Improvement Permit by: AS date 9/19/03

Operation Permit by: AS date 11/19/03

Authorization to Construct by: AS date 9/23/03

Existing System Inspection by: date

HEALTH DEPT. COPY: WHITE OWNER COPY (FINAL): YELLOW OWNER COPY (INITIAL): PINK