4649-04-8645

11:30

IREDELL COUNTY HEALTH DEPARTMENT

STATESVILLE 704-878-5305 MOORESVILLE 704-664-5281

IMPROVEMENT PERMIT / AUTHORIZATION TO CONSTRUCT / OPERATION PERMIT / EXISTING SYSTEM INSPECTION

PERMIT# 134421 PIN# 4649 04 9474.003 DATE 7-16-08

OWNER OR APPLICANT Lewis Carpenter PHONE: Business (704) 634-5183 Home

ADDRESS P.O. Box 690027 Charlotte, NC 28227

LOCATION Perth Rd N past Judas TR Wild Cherry Ln TL Orchard Farms Ln 3rd lot on left

SUBDIVISION The Orchard BLOCK / SECTION LOT 3 LOT AREA 25,892 ft² SITE CLASS. RS DESIGN FLOW 480gpd L.T.A.R. .3

Septic Tank: 1000 Gallons: STB 794 Date 7-1-08

Pump Tank: 1000 Gallons: PT 283 Date 7-4-08

Pump Make: Goulds Model WE0512H Serial No.

Nitrification Field: No Fields 1 Square Feet 1200 Linear Feet 400'

No Lines 4@100' Trench Width 36" Max Trench Bottom Depth 36"

☒ New System ☐ Repair ☐ Expansion System Type: I II III IV V VI

System Description: Pump-Pm-25% Reduction

Repair System Description: Pump-LP-Panel Blk

Maintenance Agreement Required: ☐ Yes ☒ No Not Initially

☒ House/Mod. Home ☐ Mobile Home ☐ Business ☐ Other

No. Bedrooms 4 No. Persons No. Employees


Water Supply: ☒ Individual ☐ Public ☐ Community

Gravel Depth N/A ☐ Gravity ☒ Pressure ☐ Slab ☒ Crawl Space ☐ Basement w/plumbing ☐ Basement wo/plumbing

Comments/Conditions: This permit replaces previous dated 10-16-06 Must keep tanks at least 50Ft From any well

Comments/Conditions: 8" 408 2Ft head set, tanks & lines Checked

INITIAL SITE SKETCH Scale 1:50'

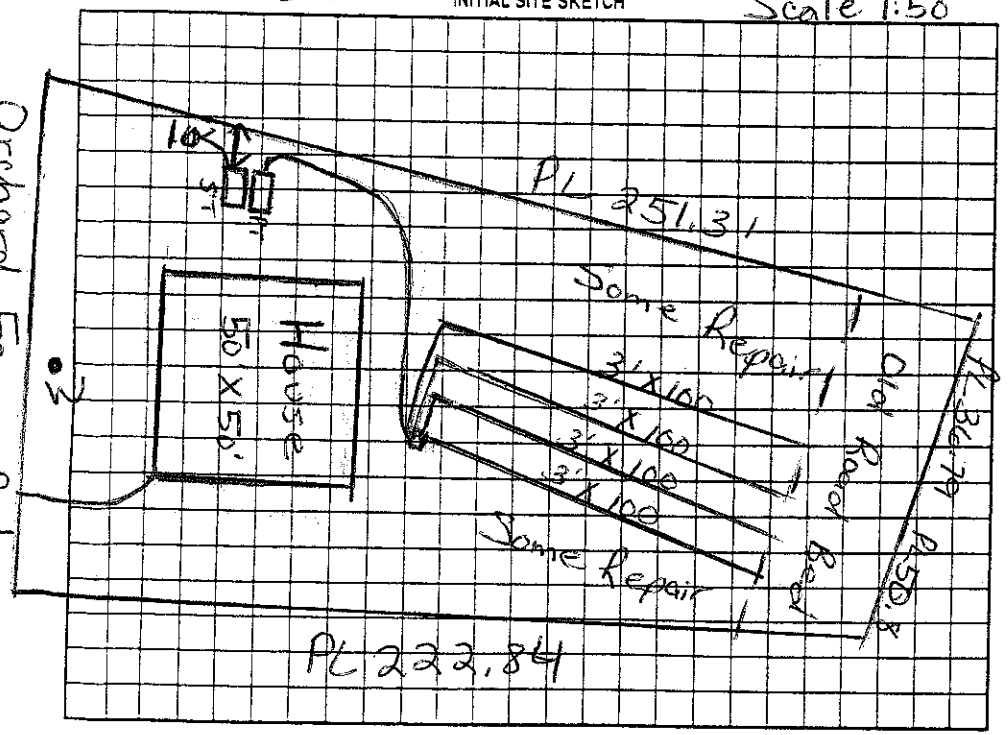

AS BUILT SKETCH

Installed Quick 4 for Drainfield

Permit can be suspended or revoked if any false information is supplied toward securing the permit/any unauthorized changes are made to the site/any unauthorized changes are made in the installation of the system. Improvement Permit with plat valid without expiration ☐ Improvement Permit with site plan valid for sixty months ☐ Authorization to Construct is valid for a period equal to that of Improvement Permit – not to exceed sixty months.

Signed: Lewis Carpenter date 7-17-08 Installed by: Larry Beam Grading

Improvement Permit by: Marian H. Olsen RS date 7/16/08 Operation Permit by: date 4-7-09

Authorization to Construct by: Marian H. Olsen RS date 7/16/08 Existing System Inspection by: date

HEALTH DEPT. COPY: WHITE OWNER COPY (FINAL): YELLOW OWNER COPY (INITIAL): PINK