IREDELL COUNTY HEALTH DEPARTMENT

Statesville Office (704) 878-5305 Mooresville Office (704) 660-3625 PERMIT # 209405

IMPROVEMENT PERMIT / AUTHORIZATION TO CONSTRUCT / OPERATION PERMIT / EXISTING SYSTEM

PIN # 4649-05-0076.000

APPLICANT: Luis Gryniero APPLICANT ADDRESS: 124 N San Agustine Dr. Mooresville, NC

SITE ADDRESS: 124 N. San Agustine Dr. Mooresville NC PHONE: 402-926-1766 ALT. PHONE:

SITE DIRECTIONS: Perth Rd. To Bells Crossing. Tr San Agustin. Site on R

SUBDIVISION: Bells Crossing SECTION: LOT # 18 LOT AREA: .590 Acre DESIGN FLOW: 480 GPD L.T.A.R.: .3

Septic Tank 1000 Exist. (gal) STB Date
Pump Tank (gal) PT Date
Pump Make Model Serial #
Nitrification Fields 1 Ex. # Lines 5 Existing Linear Ft: 400' Ex.
Trench Width 36" Ex. Max. Trench Bottom Depth Existing Gravel Depth N/A


☐ New System ☐ Repair ☐ Expansion System Type: I II (III) IV V VI
System Description: 25% Reduction - Gravity
Repair System Description: LP - PMBPS
Maintenance Agreement Required: ☐ YES ☒ NO
☒ GRAVITY ☐ PRESSURE

☒ Residence No. Bedrooms 4
☐ Business No. Persons 8
☐ Other No. Employees
☐ Slab ☐ Crawl Space
☐ Basement w/plumbing ☐ Basement w/o plumbing


Water Supply: ☒ Private ☐ Public ☐ Community

Comments / Conditions: This Permit is an Intermediate Relayout for a 18'x32' Pool. Extra Repair Line was Initially Layed out with the Pool Addition there is 272' left for LP Panel Repair (4 Bedroom Repair).
- Maintain 15' Seperation with Pool and Repair Area.

INITIAL SITE SKETCH

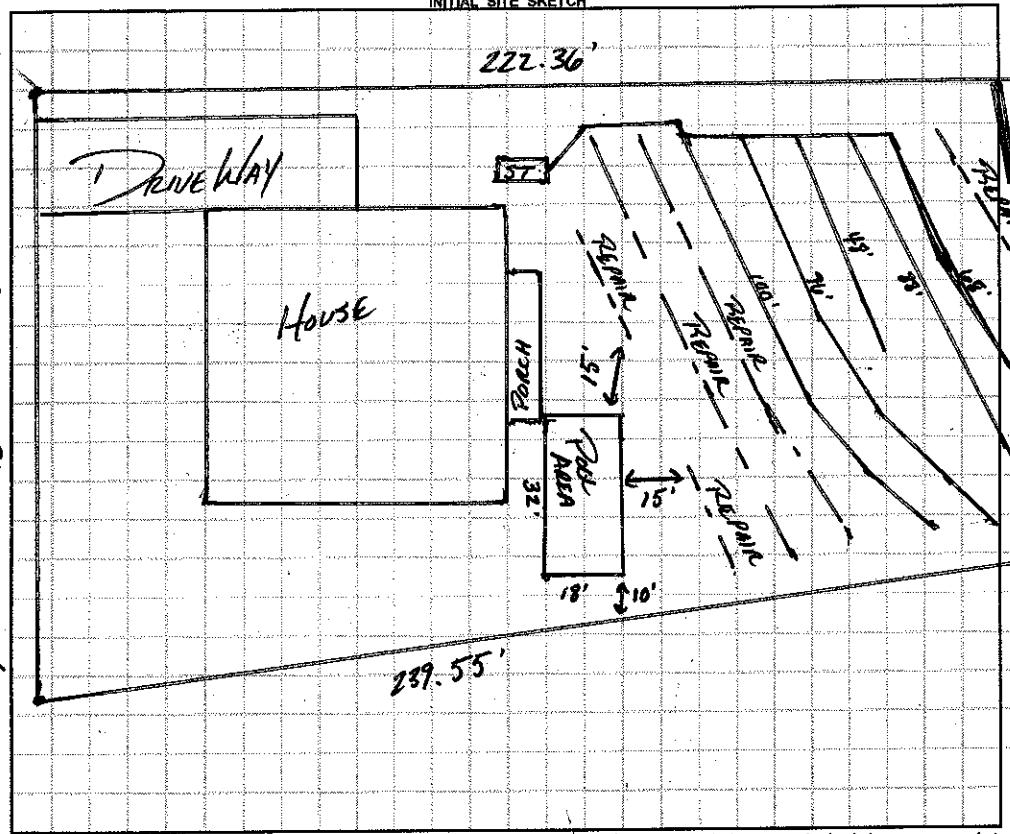

AS BUILT SKETCH

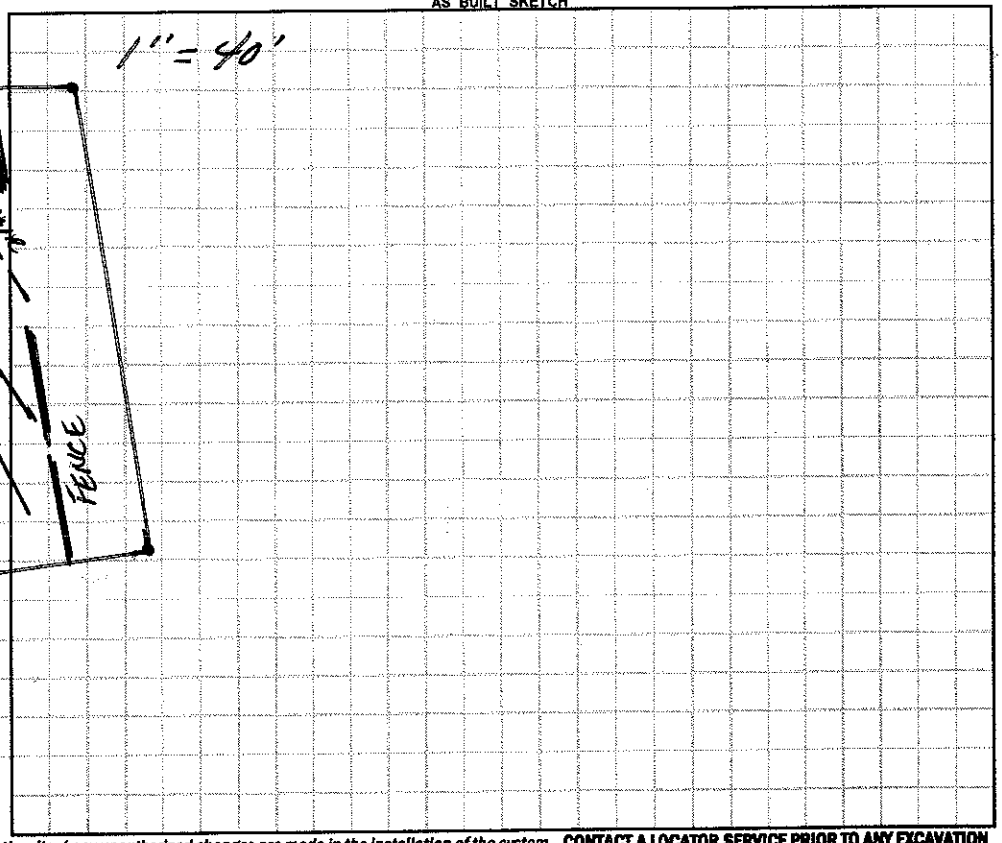

Permit can be suspended or revoked if any false information is supplied toward securing the permit / any unauthorized changes are made to the site / any unauthorized changes are made in the installation of the system. **CONTACT A LOCATOR SERVICE PRIOR TO ANY EXCAVATION**

☐ **IMPROVEMENT PERMIT** *with plat valid without expiration.* ☒ **IMPROVEMENT PERMIT** *with site plan valid for 60 mos.* ☒ **AUTHORIZATION TO CONSTRUCT** *valid for period equal to IMPROVEMENT PERMIT--not to exceed 60 mo.*

Owner / Applicant Signature: Luis M. Gryniero Date: 4/20/15 Installed by:

IMPROVEMENT PERMIT / Date: EDA

AUTHORIZATION TO CONSTRUCT by: / Date: 4-20-15 OPERATION PERMIT by: Date:

Existing System Inspected by: APPROVED Date: APR 20 2015


Health Dept. Copy - WHITE Applicant (Final Approval) - YELLOW Applicant (Conditional Approval) - PINK

10	PINK	6.6	40	40

30" TRENCH DEPTH MAX

FOR GENERAL USE NOT A SURVEY
PRELIMINARY NOT FOR CONSTRUCTION

SOIL PROFILES AND ANALYSIS PROVIDED BY
CENTRAL CAROLINA SOIL CONSULTING PLLC

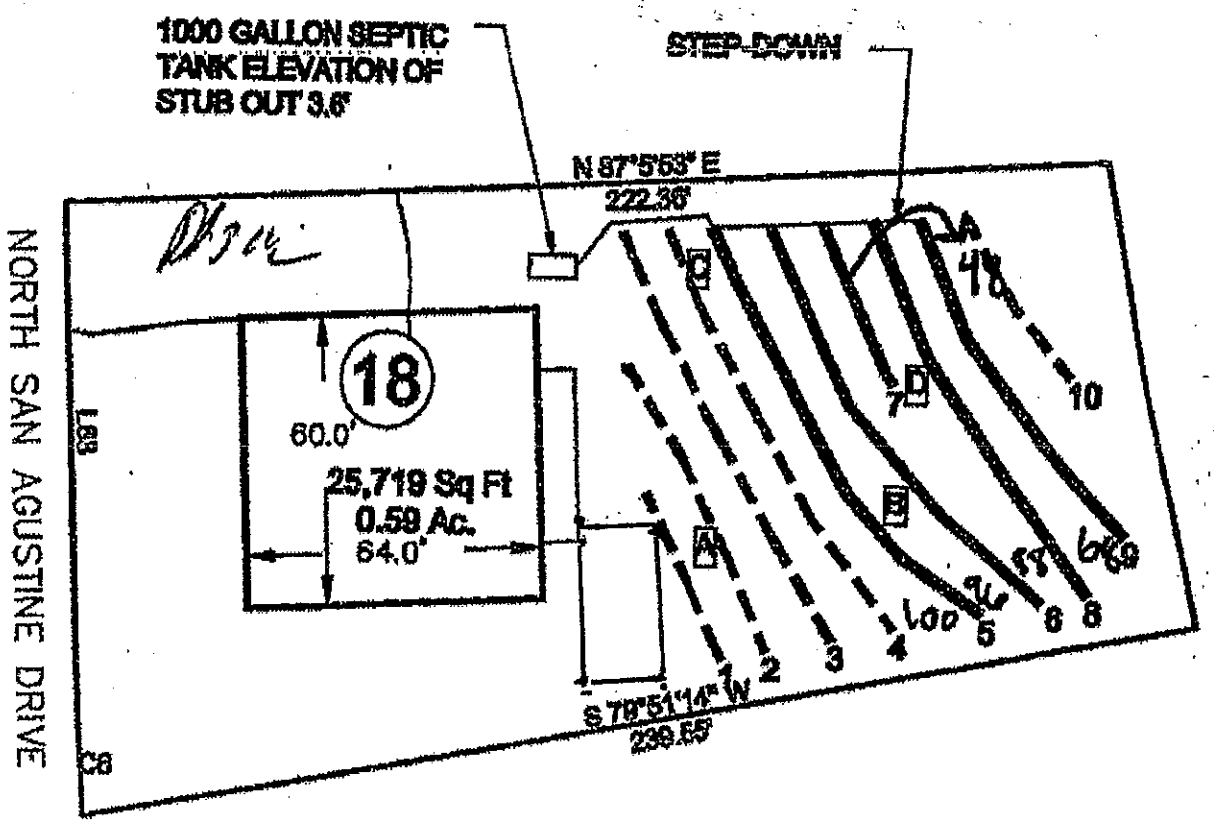

IARY SYSTEM

IREDELL COUNTY HEALTH DEPARTMENT

Statesville Office (704) 878-5305 Mooresville Office (704) 660-3625 PERMIT # 18135 3

IMPROVEMENT PERMIT / AUTHORIZATION TO CONSTRUCT / OPERATION PERMIT / EXISTING SYSTEM

PIN # 4649050076

APPLICANT: MERITAGE HOMES APPLICANT ADDRESS: 11605 N COMMUNITY ST 250 CHARLOTTE NC 28217

SITE ADDRESS: 124 N SAN AUGUSTIN PHONE: ALT. PHONE:

SITE DIRECTIONS: PERTH(N) - TL BELLS CROSSING - TR SAN AUGUSTIN - ON RT

SUBDIVISION: BELLS CROSSING SECTION: LOT # 18 LOT AREA: .57AC DESIGN FLOW: 480 L.T.A.R.: .3

Septic Tank 1000 (gal) STB 760 Date 5-30
Pump Tank (gal) PT Date
Pump Make Model Serial #
Nitrification Fields 1 # Lines 5 Linear Ft: 400
Trench Width 36" Max. Trench Bottom Depth 24" Gravel Depth N/A

☑ New System ☐ Repair ☐ Expansion System Type: I II III IV V VI
System Description: GRAVITY 25% REDUCTION
Repair System Description: PUMP SAME
Maintenance Agreement Required: ☐ YES ☑ NO
☑ GRAVITY ☐ PRESSURE

☑ Residence No. Bedrooms 4
☐ Business No. Persons 8
☐ Other No. Employees
☑ Slab ☐ Crawl Space
☐ Basement w/plumbing ☐ Basement w/o plumbing

Water Supply: ☑ Private ☐ Public ☐ Community

Comments / Conditions:

INITIAL SITE SKETCH

SEE BATEMAN CIVIL SURVEY'S PLAN

AS BUILT SKETCH

Permit can be suspended or revoked if any false information is supplied toward securing the permit / any unauthorized changes are made to the site / any unauthorized changes are made in the installation of the system. **CONTACT A LOCATOR SERVICE PRIOR TO ANY EXCAVATION**

☐ **IMPROVEMENT PERMIT** *with plat valid without expiration.* ☑ **IMPROVEMENT PERMIT** *with site plan valid for 60 mos.* ☐ **AUTHORIZATION TO CONSTRUCT** *valid for period equal to IMPROVEMENT PERMIT--not to exceed 60 mo.*

Owner / Applicant Signature: Date: 8-6-14 Installed by:

IMPROVEMENT PERMIT by: Date: 8/01/14 OPERATION PERMIT by: APPROVED AUG 28 2014 Date:

AUTHORIZATION TO CONSTRUCT by: Date: 8/01/14 Existing System Inspected by: Date:

Health Dept. Copy - WHITE Applicant (Final Approval) - YELLOW Applicant (Conditional Approval) - PINK