IREDELL COUNTY HEALTH DEPARTMENT

STATESVILLE 704-878-5305 MOORESVILLE 704-664-5281

IMPROVEMENT PERMIT / AUTHORIZATION TO CONSTRUCT / OPERATION PERMIT / EXISTING SYSTEM INSPECTION

PERMIT# 112884 PIN# 4649 05 5941 DATE 1/26/05

OWNER OR CONTRACTOR Corinthian Developers. PHONE: Business 704-827-9697 Home

ADDRESS PO Box 990 Denver, NC. 28037

LOCATION Perth Rd N TR Draycliff near cul de sac on R

SUBDIVISION Draycliff BLOCK / SECTION 1 LOT 21 LOT AREA .611 Ac SITE CLASS P5 DESIGN FLOW 360GPD L.T.A.R. .3

Septic Tank: 1000 Gallons; STB Date

Pump Tank: 1000 Gallons; PT Date

Pump Make: Goulds Model PE-5 Serial No.

Nitrification Field: No Fields 1 Square Feet 420/630 Linear Feet 210

No Lines 3@70' Trench Width 2-3' Max Trench Bottom Depth 3' Gravel Depth No

☒ New System ☐ Repair System Type: I, II, III, IV, V, VI

System Description: Pressed - 16" PPBPS

Repair System Description: Same Type

Maintenance Agreement Required: ☒ Yes ☐ No

☒ House/Mod. Home No. Bedrooms 3

☐ Mobile Home No. Bathrooms 3

☐ Business No. Employees

☐ Other

☐ Slab ☐ Crawl Space ☒ Basement w/plumbing ☐ Basement wo/plumbing


Water Supply: ☒ Individual ☐ Public ☐ Community

Comments:/Conditions: House too large to install system on front side of gully. Must be installed on back of gully area.


Comments:/Conditions: 6 devices @ 35'x2' each off of Zero Manifold

1" = 50'

INITIAL SITE SKETCH

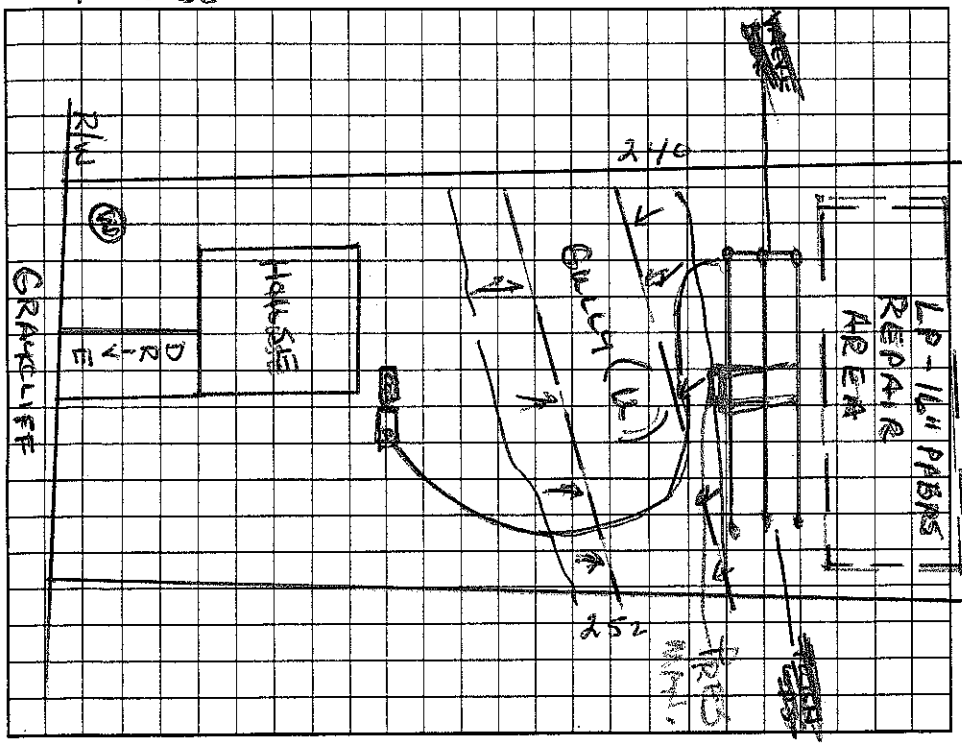

AS BUILT SKETCH

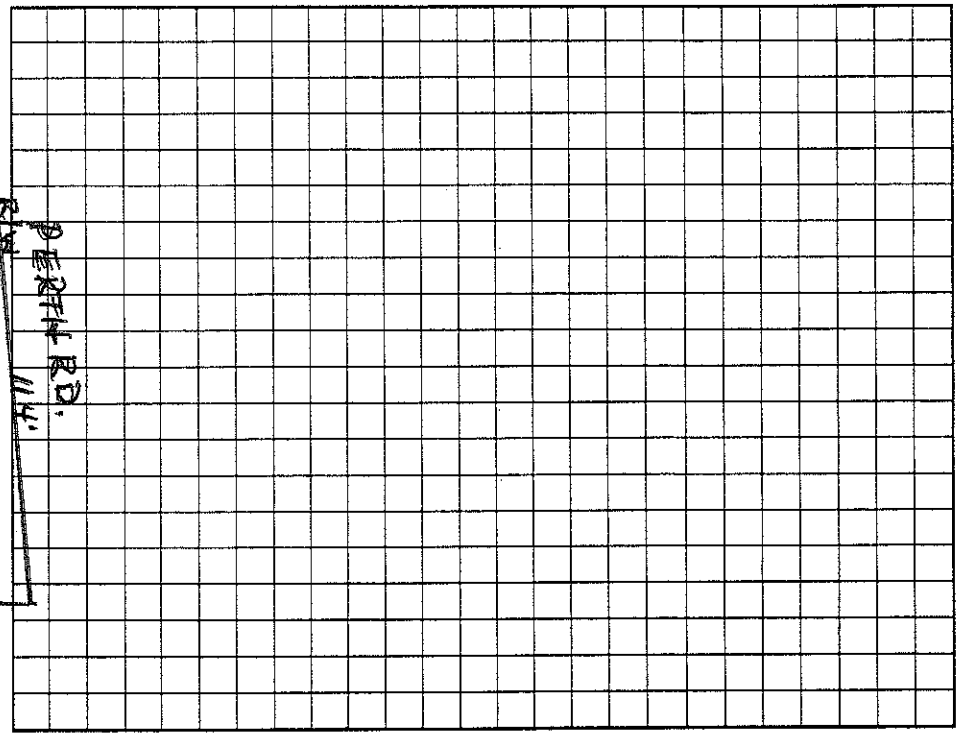

Permit can be suspended or revoked if any false information is supplied toward securing the permit/any unauthorized changes are made to the site/any unauthorized changes are made in the installation of the system. Improvement Permit with plat valid without expiration. Improvement Permit with site plan valid for sixty months. Authorization to Construct is valid for a period equal to that of Improvement Permit – not to exceed sixty months.

Signed: date

Improvement Permit by: Wesley Sparks RS. date 1/26/05

Authorization to Construct by: Wesley Sparks RS. date 1/26/05

Installed by: Corinthian Development.

Operation Permit by: Wesley Sparks RS date 2/11/05

Existing System Inspection by: date

HEALTH DEPT. COPY: WHITE OWNER COPY (FINAL): YELLOW OWNER COPY (INITIAL): PINK