IREDELL COUNTY HEALTH DEPARTMENT

Statesville Office (704) 878-5305 RA Mooresville Office (704) 660-3625

PERMIT # 209018

IMPROVEMENT PERMIT / AUTHORIZATION TO CONSTRUCT / OPERATION PERMIT / EXISTING SYSTEM

PIN # 4649-05-4141.000

APPLICANT: Faith Wood Construction

APPLICANT ADDRESS: 2003 Magna Ln. Indian Trail, NC

SITE ADDRESS: 156 Gray Cliff Dr. Mooresville NC 28117

PHONE: 980-721-7797 ALT. PHONE: 704-609-3936

SITE DIRECTIONS: Perth Rd., to Gray Cliff, Site on R


SUBDIVISION: Grey Cliff

SECTION: LOT # 21 LOT AREA: .611 Acre DESIGN FLOW: Ex. 360 L.T.A.R.: Existing


Septic Tank Ex (gal)	STB	Date	☐ New System ☐ Repair ☐ Expansion System Type: I II III IV V VI	☒ Residence	No. Bedrooms	Ex 3	Water Supply
Pump Tank Ex (gal)	PT	Date	System Description: Existing PM Pipes	☐ Business	No. Persons	Ex 6	☒ Private
Pump Make	Model	Serial #	Repair System Description:	☐ Other	No. Employees		☐ Public
# Nitrification Fields Ex.	# Lines Ex.	Linear Ft: Ex.	Maintenance Agreement Required: ☐ YES ☐ NO	☐ Slab	Crawl Space		☐ Community
Trench Width Ex.	Max. Trench Bottom Depth Ex.	Gravel Depth N/A	☐ GRAVITY ☐ PRESSURE	☒ Basement w/plumbing			☐ Basement w/o plumbing

Comments / Conditions: Deck Addition Must Be 5' From Tanks.

INITIAL SITE SKETCH

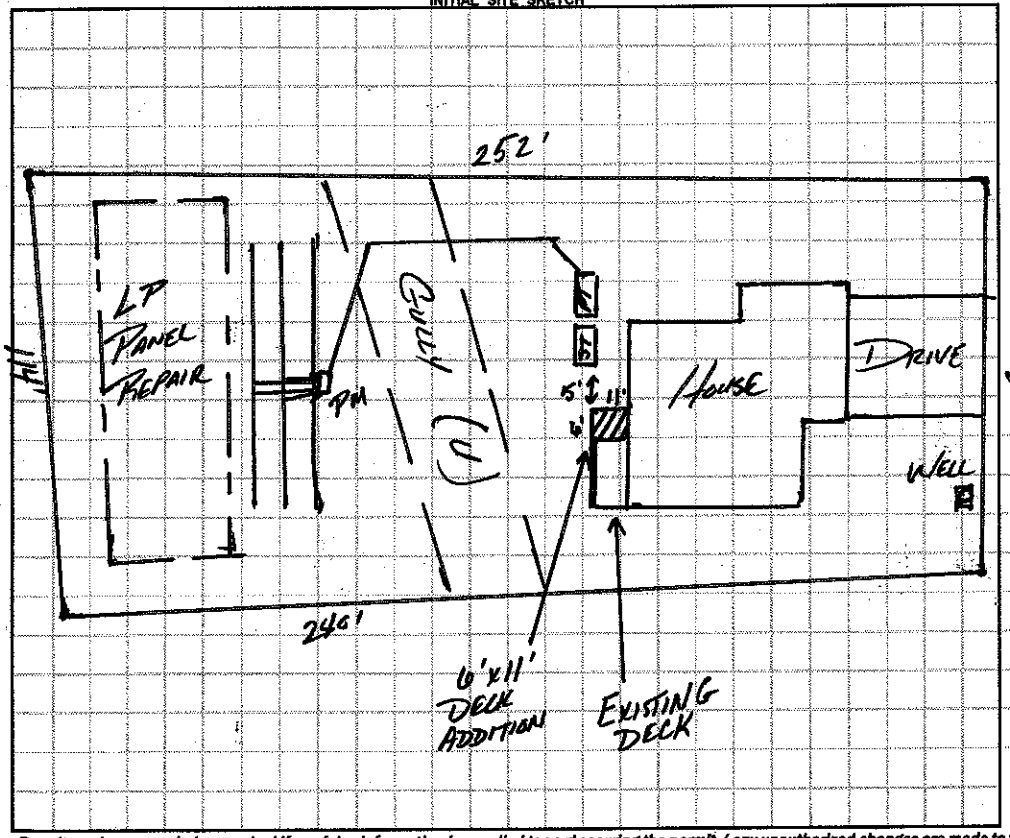

AS BUILT SKETCH

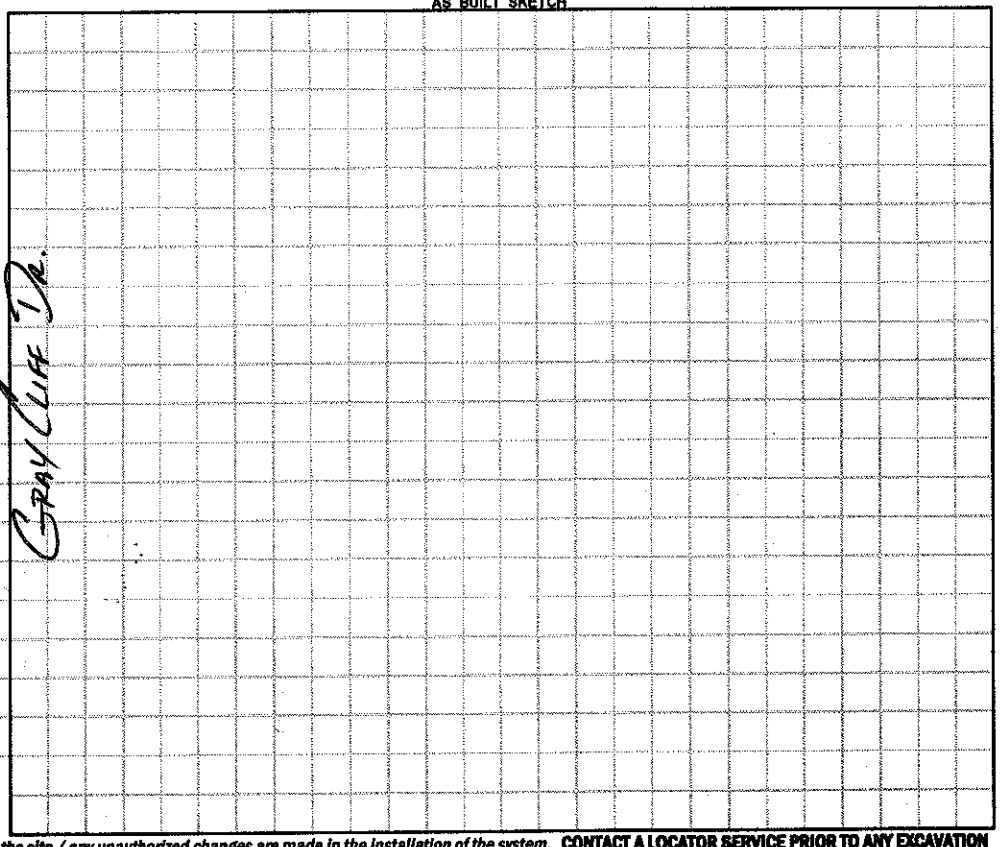

Permit can be suspended or revoked if any false information is supplied toward securing the permit / any unauthorized changes are made to the site / any unauthorized changes are made in the installation of the system. **CONTACT A LOCATOR SERVICE PRIOR TO ANY EXCAVATION**

☐ **IMPROVEMENT PERMIT** *with plat valid without expiration.* ☐ **IMPROVEMENT PERMIT** *with site plan valid for 60 mos.* ☐ **AUTHORIZATION TO CONSTRUCT** *valid for period equal to IMPROVEMENT PERMIT--not to exceed 60 mo.*

Owner / Applicant Signature: _____ Date: 4-29-15 Installed by: _____

IMPROVEMENT PERMIT by: _____ Date: _____ OPERATION PERMIT by: _____ Date: _____

AUTHORIZATION TO CONSTRUCT by: _____ Date: _____ Existing System Inspected by: _____ Date: APR 10 2015

APPROVED

Health Dept. Copy - WHITE Applicant (Final Approval) - YELLOW Applicant (Conditional Approval) - PINK