IREDELL COUNTY HEALTH DEPARTMENT

STATESVILLE 704-878-5305 MOORESVILLE 704-664-5281

IMPROVEMENT PERMIT / AUTHORIZATION TO CONSTRUCT / OPERATION PERMIT / EXISTING SYSTEM INSPECTI

PERMIT# 112886 PIN# ~~4649 05 5544.22~~ 4649-05-4204 DATE 10/6/03

OWNER OR CONTRACTOR CORINTHIAN DEVELOPERS PHONE: Business 827-9699 Home

ADDRESS PO BOX 990 DENVER NC 28037

LOCATION PERTH NORTH · TR GRAYCLIFF ON RT

SUBDIVISION GRAY CLIFF BLOCK / SECTION LOT 22 LOT AREA .579AC SITE CLASS PS DESIGN FLOW 360 GPD L.T.A.R. .25 GPD/FT²

Septic Tank: 1000 Gallons; STB 55 Date 12/10/03
Pump Tank: Gallons; PT Date
Pump Make: Model Serial No.
Nitrification Field: No Fields 1 Square Feet 450 Linear Feet 240
No Lines 8@30' Trench Width 24" Max Trench Bottom Depth 36" Gravel Depth N/A

☑ New System ☐ Repair System Type: I, II, III, IV, V, VI
System Description: GRAVITY PANEL
Repair System Description: LP PANEL
Maintenance Agreement Required: ☐ Yes ☑ No


☑ House/Mod. Home No. Bedrooms 3
☐ Mobile Home No. Bathrooms 3
☐ Business No. Employees
☐ Other
☐ Slab ☑ Crawl Space ☐ Basement w/plumbing ☐ Basement wo/plumbing

Water Supply: ☑ Individual ☐ Public ☐ Community


Comments:/Conditions: 6 4 @ 60' PANEL LINES SPLIT IN MIDDLE - DO NOT CUT OR FILL HOUSE SITE. - HIGH CRAWL SPACE

Comments:/Conditions:

INITIAL SITE SKETCH

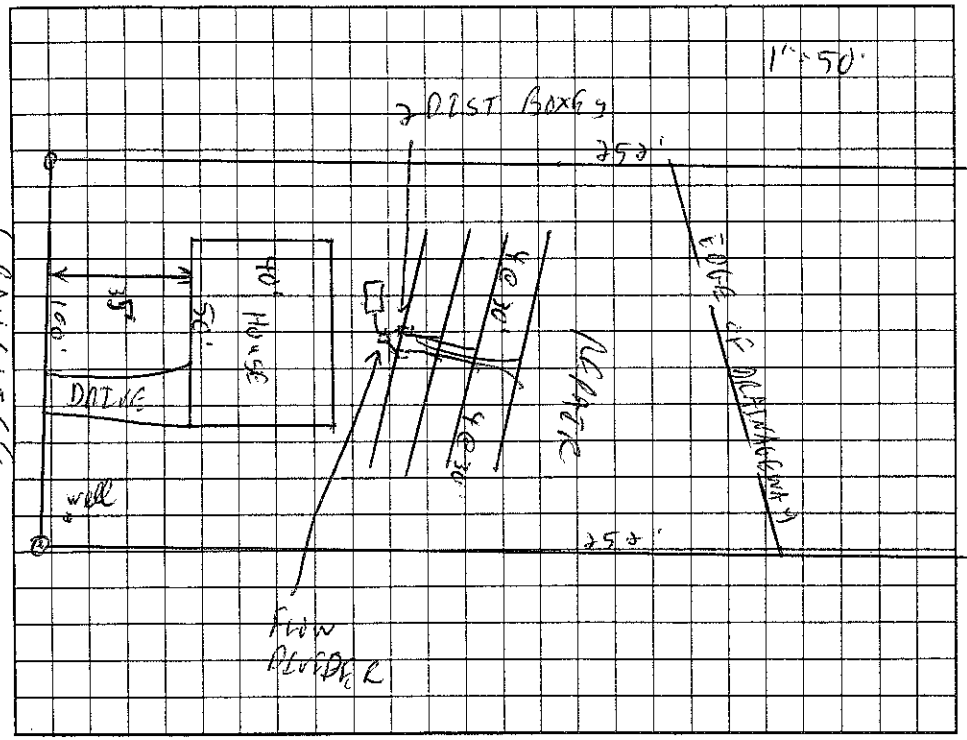

AS BUILT SKETCH

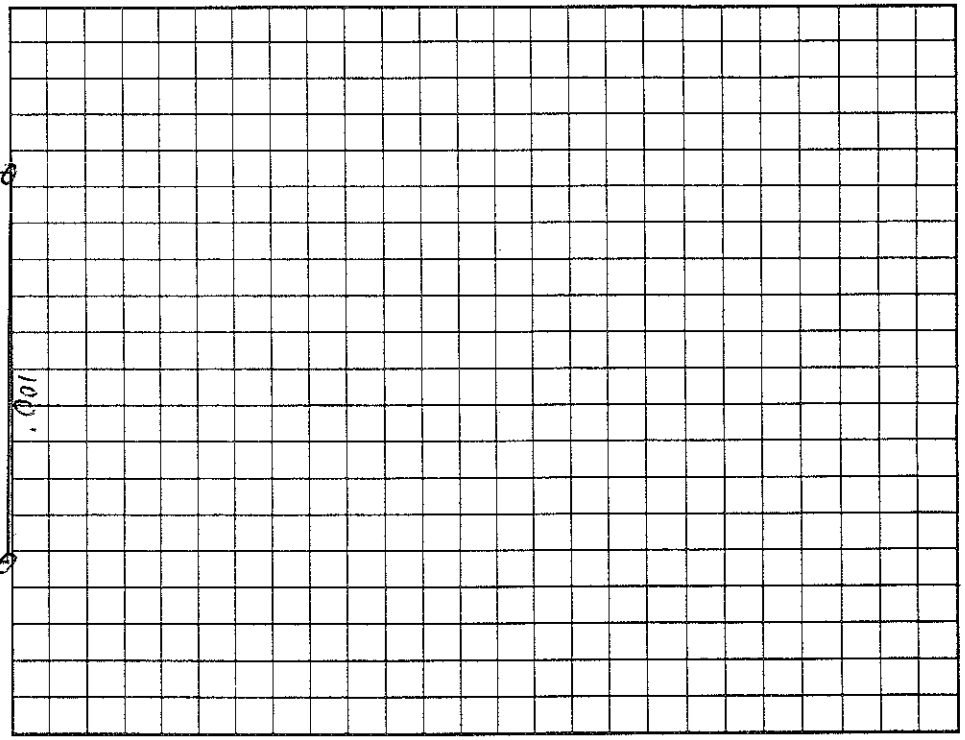

Permit can be suspended or revoked if any false information is supplied toward securing the permit/any unauthorized changes are made to the site/any unauthorized changes are made in the installation of the system. Improvement Permit with plat valid without expiration. Improvement Permit with site plan valid for sixty months. Authorization to Construct is valid for a period equal to that of Improvement Permit – not to exceed sixty months.

Signed: date 10-6-03 Installed by: Corinthian Builders

Improvement Permit by: RS date 10/6/03 Operation Permit by: RS date 4/27/04

Authorization to Construct by: RS date 12/22/03 Existing System Inspection by: date

HEALTH DEPT. COPY: WHITE OWNER COPY (FINAL): YELLOW OWNER COPY (INITIAL): PINK