IREDELL COUNTY HEALTH DEPARTMENT

STATESVILLE 704-878-3205 MOORESVILLE 704-664-5281

IMPROVEMENT PERMIT / AUTHORIZATION TO CONSTRUCT / OPERATION PERMIT / EXISTING SYSTEM INSPECTION

200

PERMIT# 112888 PIN# ~~4649-05-5541.23~~ 4649-05-4341 DATE 9/2/03

OWNER OR CONTRACTOR CORINTHIAN DEVELOPERS LTD PHONE: Business 827-9697 Home

ADDRESS PO BOX 990 DENVER NC 28037

LOCATION DERITH NORTH - TR GRAYCLIFF - ON RT

SUBDIVISION GRAYCLIFF BLOCK / SECTION LOT 23 LOT AREA .579 SITE CLASS. AS DESIGN FLOW 360GPD L.T.A.R. .250 GPD/FT±

Septic Tank: 1000 Gallons; STB 786 Date 4/22/05

Pump Tank: Gallons; PT Date

Pump Make: Model Serial No.

Nitrification Field: No Fields 1 Square Feet 480 Linear Feet 240

No Lines 8@30' Trench Width 24" Max Trench Bottom Depth 30" Gravel Depth N/A

☑ New System ☐ Repair System Type: I, II, (III), IV, V, VI

System Description: GRAVITY PANEL

Repair System Description: ~~SAM~~ LP PANEL

Maintenance Agreement Required: ☐ Yes ☑ No

☑ ~~House/Mod. Home~~ No. Bedrooms 3

☐ Mobile Home No. Bathrooms 3

☐ Business No. Employees

☐ Other


☐ Slab ☑ Crawl Space ☐ Basement w/plumbing ☐ Basement wo/plumbing

Water Supply: ☑ ~~Individual~~ ☐ Public ☐ Community


Comments:/Conditions:

Comments:/Conditions:

INITIAL SITE SKETCH

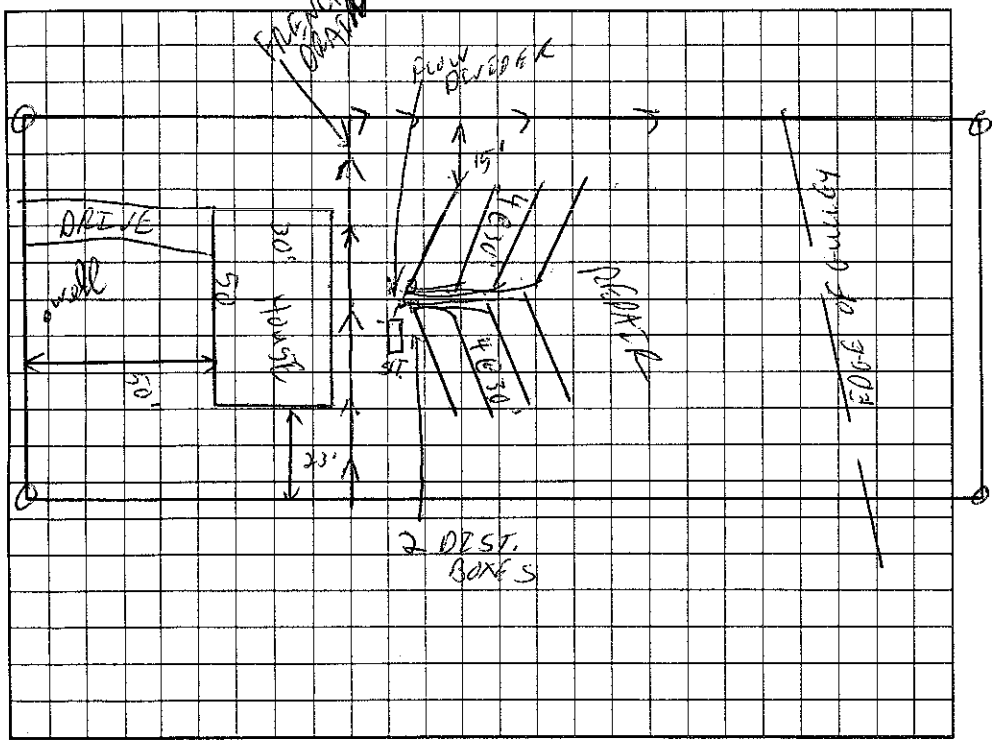

AS BUILT SKETCH

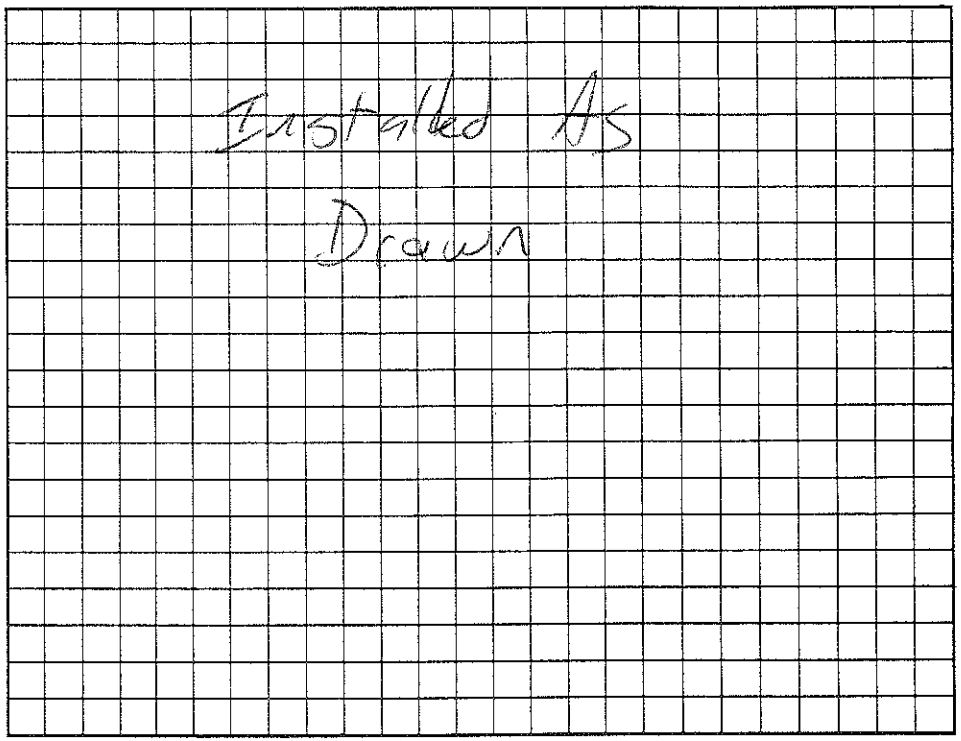

Permit can be suspended or revoked if any false information is supplied toward securing the permit/any unauthorized changes are made to the site/any unauthorized changes are made in the installation of the system. Improvement Permit with plat valid without expiration. Improvement Permit with site plan valid for sixty months. Authorization to Construct is valid for a period equal to that of Improvement Permit – not to exceed sixty months.

Signed: date

Improvement Permit by: RS date 9/2/03

Authorization to Construct by: RS date 2/25/05

Installed by: Corinthian Blders

Operation Permit by: RS date 6/15/05

Existing System Inspection by: date

HEALTH DEPT. COPY: WHITE OWNER COPY (FINAL): YELLOW OWNER COPY (INITIAL): PINK