# IREDELL COUNTY HEALTH DEPARTMENT

Statesville Office (704) 878-5305 Mooresville Office (704) 660-3625 PERMIT # 209940

## IMPROVEMENT PERMIT / AUTHORIZATION TO CONSTRUCT / OPERATION PERMIT / EXISTING SYSTEM

PIN # 4649054341

APPLICANT: John & Mona Armstrong APPLICANT ADDRESS: 148 Greycliff Dr Mooresville, NC 28117

SITE ADDRESS: 148 Greycliff Dr Mooresville, NC 28117 PHONE: ALT. PHONE: 704 200 8547

SITE DIRECTIONS: Hwy 150 W. TR Perth Rd TR Greycliff go uphill on right

SUBDIVISION: Grey Cliff SECTION: LOT # 23 LOT AREA: .57 Ac. DESIGN FLOW: 360gpd L.T.A.R.: .25

Exist

Septic Tank 1000 (gal) STB Date
Pump Tank (gal) PT Date
Pump Make Model Serial #
# Nitrification Fields 1 # Lines 8 @ 30' ea Linear Ft: 240'
Trench Width 24" Max. Trench Bottom Depth 30" Gravel Depth N/A

☐ New System ☐ Repair ☐ Expansion System Type: I II III IV V VI
System Description: Exist. Gravity - Panel Block
Repair System Description: 1P Panel Block
Maintenance Agreement Required: ☐ YES ☒ NO
☒ GRAVITY ☐ PRESSURE


☒ Residence No. Bedrooms 3
☐ Business No. Persons 6
☒ Other Shed No. Employees
☐ Slab ☒ Crawl Space
☐ Basement w/plumbing ☐ Basement w/o plumbing

Water Supply: ☒ Private ☐ Public ☐ Community

Comments / Conditions:

The proposed shed does not appear to impact the existing on-site septic system or well. It meets setbacks to all septic areas.

INITIAL SITE SKETCH

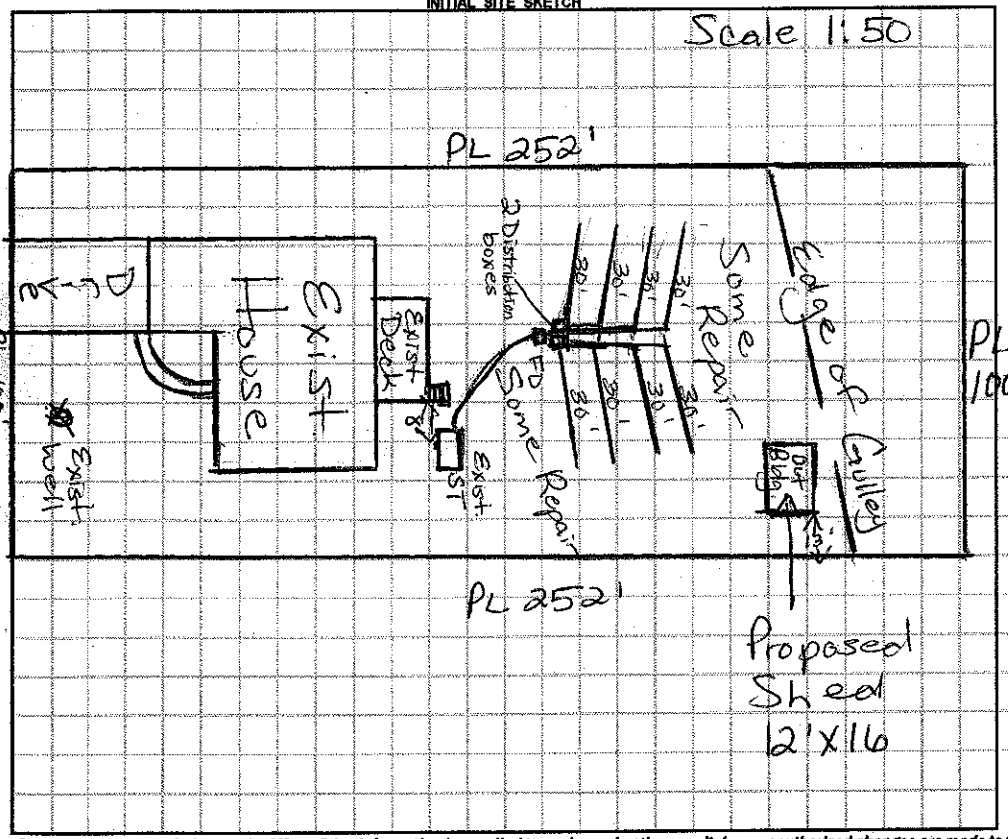


AS BUILT SKETCH

*Permit can be suspended or revoked if any false information is supplied toward securing the permit / any unauthorized changes are made to the site / any unauthorized changes are made in the installation of the system.* **CONTACT A LOCATOR SERVICE PRIOR TO ANY EXCAVATION**

☐ **IMPROVEMENT PERMIT** *with plat valid without expiration.* ☐ **IMPROVEMENT PERMIT** *with site plan valid for 60 mos.* ☐ **AUTHORIZATION TO CONSTRUCT** *valid for period equal to IMPROVEMENT PERMIT--not to exceed 60 mo.*

Owner / Applicant Signature: Date: 6/1/15 Installed by: Corinthian Builders 6/15/05

IMPROVEMENT PERMIT by: Date: OPERATION PERMIT by: Date:

AUTHORIZATION TO CONSTRUCT by: Date: Existing System Inspected by: Marie H. Dotson RS Date: 5/29/15

Health Dept. Copy - WHITE Applicant (Final Approval) - YELLOW Applicant (Conditional Approval) - PINK