IREDELL COUNTY HEALTH DEPARTMENT

STATESVILLE 704-878-5305 MOORESVILLE 704-664-5281

IMPROVEMENT PERMIT / AUTHORIZATION TO CONSTRUCT / OPERATION PERMIT / EXISTING SYSTEM INSPECTION

PERMIT# 12-889 PIN# ~~4649055544.27~~ 4649-05-4440 DATE 9/2/03

OWNER OR CONTRACTOR CORINTHIAN DEVELOPERS PHONE: Business 827-9697 Home

ADDRESS PO BOX 990 DENVER NC 28037

LOCATION PERTH NORTH. TR GRAYCLIFF DRIVE - ON R7

SUBDIVISION GRAY CLIFF BLOCK / SECTION LOT 24 LOT AREA .579AC SITE CLASS. RS DESIGN FLOW ~~360GPD~~ 480 L.T.A.R. .25GPD/FT²

Septic Tank: 1000 Gallons; STB 785 Date 4/17/05

Pump Tank: Gallons; PT Date

Pump Make: Model Serial No.

Nitrification Field: No Fields 1 Square Feet 500 Linear Feet 250

No Lines 5@50' Trench Width 24" Max Trench Bottom Depth 30" Gravel Depth NA

☑ New System ☐ Repair System Type: I, II, III, IV, V, VI

System Description: GRAVITY PANEL

Repair System Description: LP PANEL - OFFSET

Maintenance Agreement Required: ☐ Yes ☑ No

☑ House/Mod. Home No. Bedrooms ~~3~~ 4

☐ Mobile Home No. Bathrooms 3

☑ Business No. Employees

☐ Other


☐ Slab ☑ Crawl Space ☐ Basement w/plumbing ☐ Basement wo/plumbing

Water Supply: ☑ Individual ☐ Public ☐ Community


Comments:/Conditions: House 35' From Rd - House 54' X 56'

Comments:/Conditions:

INITIAL SITE SKETCH 1"=50'

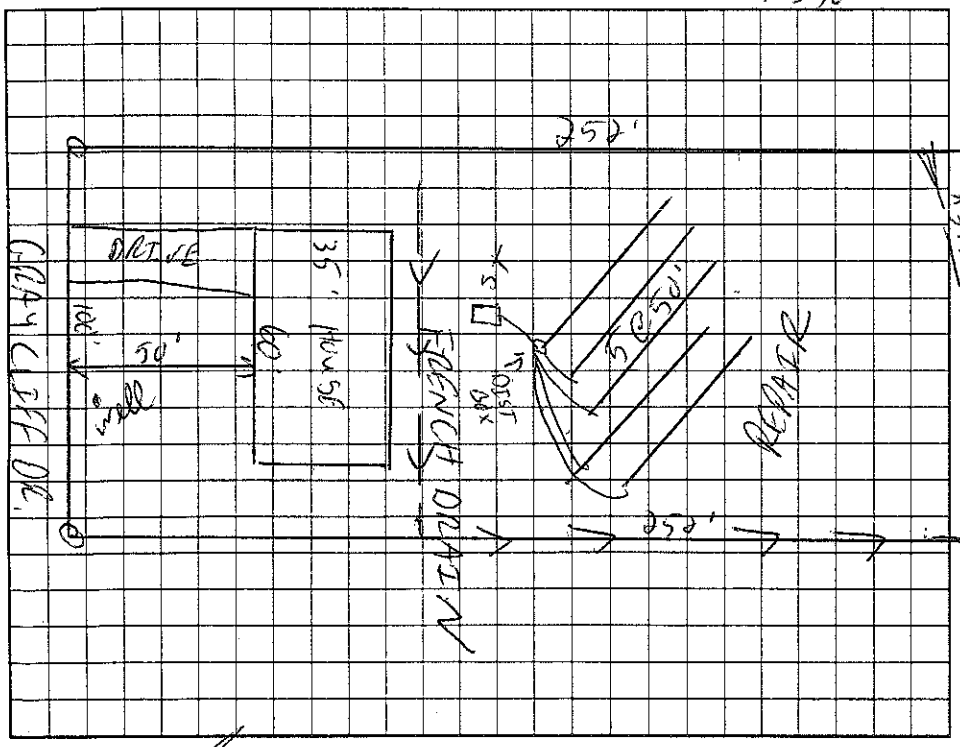

AS BUILT SKETCH

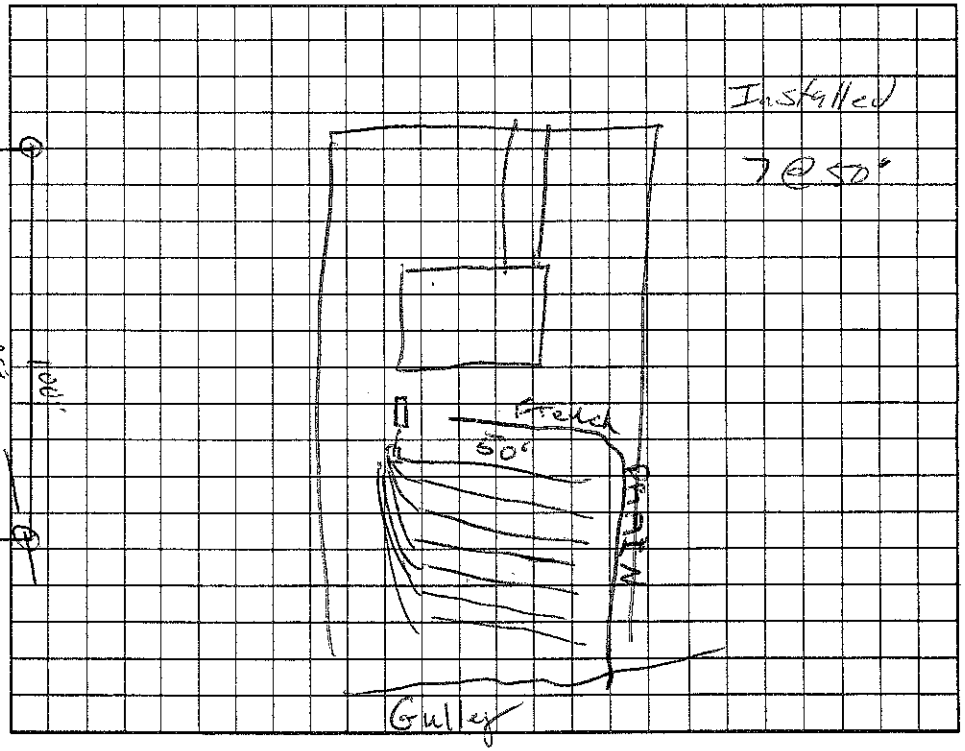

Permit can be suspended or revoked if any false information is supplied toward securing the permit/any unauthorized changes are made to the site/any unauthorized changes are made in the installation of the system. Improvement Permit with plat valid without expiration. Improvement Permit with site plan valid for sixty months. Authorization to Construct is valid for a period equal to that of Improvement Permit – not to exceed sixty months.

Signed: date

Improvement Permit by: RS date 9/2/03

Authorization to Construct by: RS date 4/25/05

Installed by: Corinthian Bldr.

Operation Permit by: RS date 10/18/05

Existing System Inspection by: date

HEALTH DEPT. COPY: WHITE OWNER COPY (FINAL): YELLOW OWNER COPY (INITIAL): PINK