IREDELL COUNTY HEALTH DEPARTMENT

STATESVILLE 704-878-5305 MOORESVILLE 704-664-5281

IMPROVEMENT PERMIT / AUTHORIZATION TO CONSTRUCT / OPERATION PERMIT / EXISTING SYSTEM INSPECTION

PERMIT# 112892 PIN# ~~4649054941.25~~ 4649-05-4550 DATE 9/3/03

OWNER OR CONTRACTOR CORINTHIAN DEVELOPERS, LTD / Highland PHONE: Business 827 9697 Home

ADDRESS PO BOX 990 DENVER NC 28037 Home Builders

LOCATION PERTH NORTH - TR GRAYCLIFF ON R7

SUBDIVISION GRAY CLIFF BLOCK / SECTION LOT 25 LOT AREA .579AC SITE CLASS. PS DESIGN FLOW 360GPD L.T.A.R. .250-PO/AT

Septic Tank: 1000 Gallons; STB 786 Date 12/16/03
Pump Tank: Gallons; PT Date
Pump Make: Model Serial No.
Nitrification Field: No Fields 1 Square Feet 500 Linear Feet 250
No Lines 5 @ 50' Trench Width 24" Max Trench Bottom Depth 36" Gravel Depth N/A

☑ New System ☐ Repair System Type: I, II, III, IV, V, VI
System Description: GRAVITY PANEL
Repair System Description: SAME
Maintenance Agreement Required: ☐ Yes ☑ No


☑ House/Mod. Home No. Bedrooms 3
☐ Mobile Home No. Bathrooms 3
☐ Business No. Employees
☐ Other
☐ Slab ☑ Crawl Space ☐ Basement w/plumbing ☐ Basement wo/plumbing

Water Supply: ☑ Individual ☐ Public ☐ Community


Comments:/Conditions: House Has to be 35' From Rd R/W - House dimensions are 47x43

Comments:/Conditions:

INITIAL SITE SKETCH 1"=50'

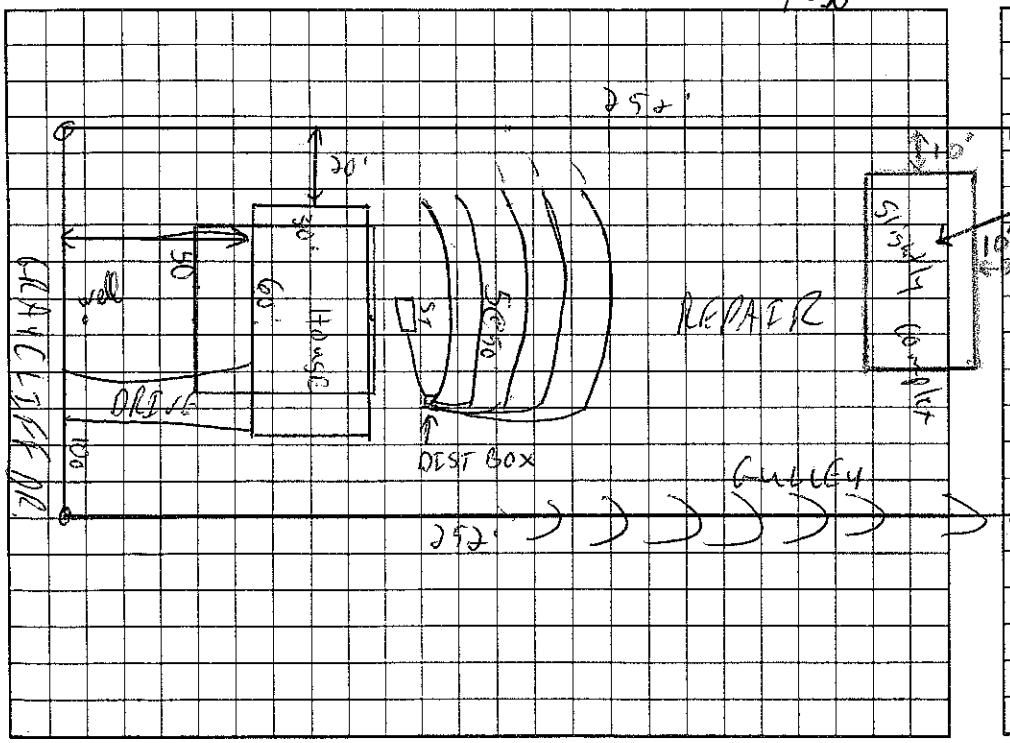

AS BUILT SKETCH

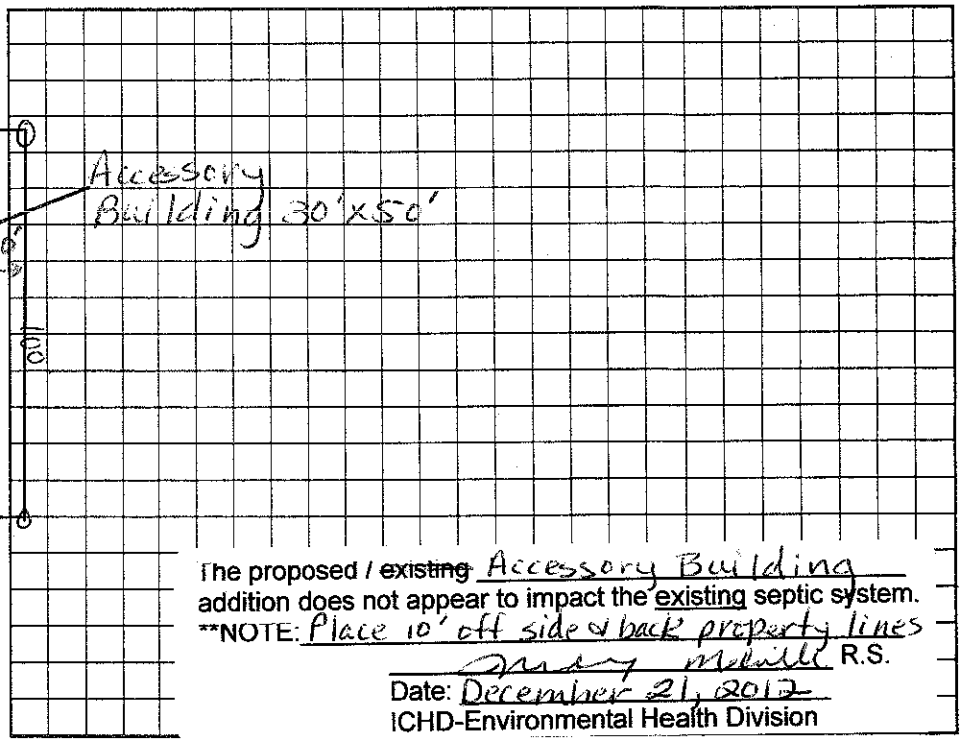

The proposed / ~~existing~~ Accessory Building addition does not appear to impact the existing septic system.
**NOTE: Place 10' off side & back property lines
R.S.
Date: December 21, 2012
ICHD-Environmental Health Division

Permit can be suspended or revoked if any false information is supplied toward securing the permit/any unauthorized changes are made to the site/any unauthorized changes are made in the installation of the system. Improvement Permit with plat valid without expiration. Improvement Permit with site plan valid for sixty months. Authorization to Construct is valid for a period equal to that of Improvement Permit – not to exceed sixty months.

Signed: date

Improvement Permit by: RS date 9/3/03

Authorization to Construct by: RS date 12/3/03

Installed by: Corinthian Bldr.

Operation Permit by: RS date 4/7/04

Existing System Inspection by: date

HEALTH DEPT. COPY: WHITE OWNER COPY (FINAL): YELLOW OWNER COPY (INITIAL): PINK