IREDELL COUNTY HEALTH DEPARTMENT

STATESVILLE 704-878-5305 MOORESVILLE 704-664-5281

IMPROVEMENT PERMIT / AUTHORIZATION TO CONSTRUCT / OPERATION PERMIT / EXISTING SYSTEM INSPECTION

PERMIT# 112893 PIN# ~~4649-05-9541.76~~ 4649-05-4650 DATE 9/3/03

OWNER OR CONTRACTOR CORINTHIAN DEVELOPERS LTD (Highland Home Builders) PHONE: Business 827-9697 Home

ADDRESS PO Box 990 DENVER NC 28037

LOCATION PERTH RD NORTH - TR GRAYCLIFF - ON R7

SUBDIVISION GRAYCLIFF BLOCK / SECTION LOT 26 LOT AREA .579AC SITE CLASS. IS DESIGN FLOW 360 L.T.A.R. .36 GPD/FT

Septic Tank: 1000 Gallons; STB 746 Date 2/5/04
Pump Tank: Gallons; PT Date
Pump Make: Model Serial No.
Nitrification Field: No Fields 1 Square Feet 400 Linear Feet 200
No Lines 4@50' Trench Width 24" Max Trench Bottom Depth 36" Gravel Depth N/A

☐ New System ☐ Repair System Type: I, II, (III) IV, V, VI
System Description: GRAVITY PANEL
Repair System Description: SAME
Maintenance Agreement Required: ☐ Yes ☑ No


☑ House/Mod. Home No. Bedrooms 3
☐ Mobile Home No. Bathrooms 3
☐ Business No. Employees
☐ Other
☐ Slab ☑ Crawl Space ☐ Basement w/plumbing ☐ Basement wo/plumbing

Water Supply: ☑ Individual ☐ Public ☐ Community


Comments:/Conditions:

Comments:/Conditions: 5/21/12 Owner dug up Dist box & TCHD adjusted speed levelers to feed evenly

INITIAL SITE SKETCH 1" = 50'

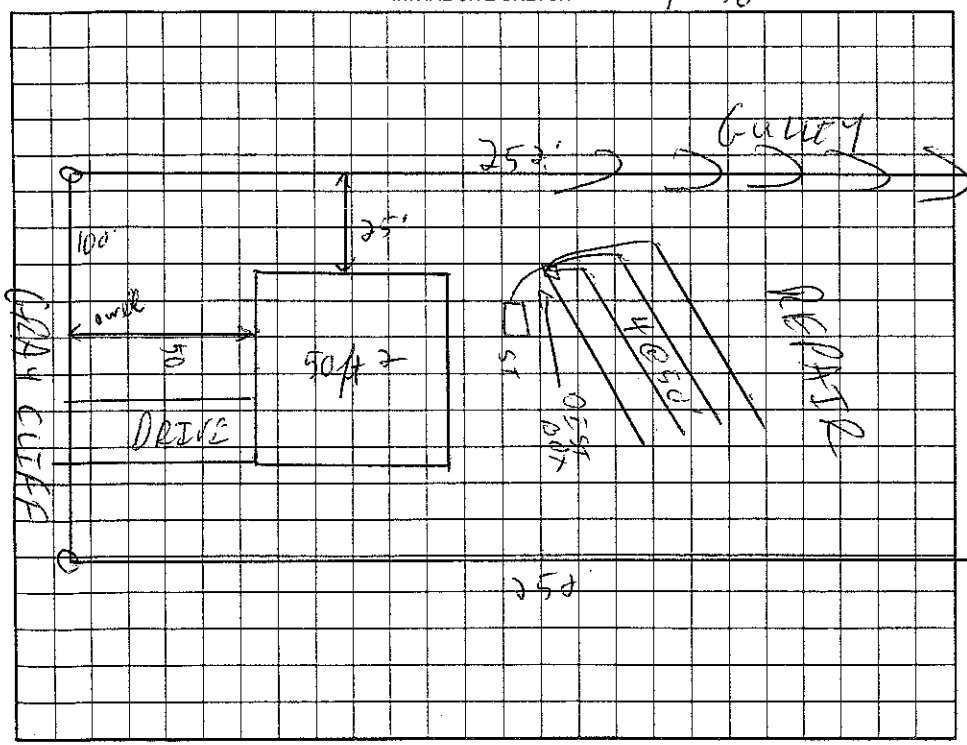

AS BUILT SKETCH

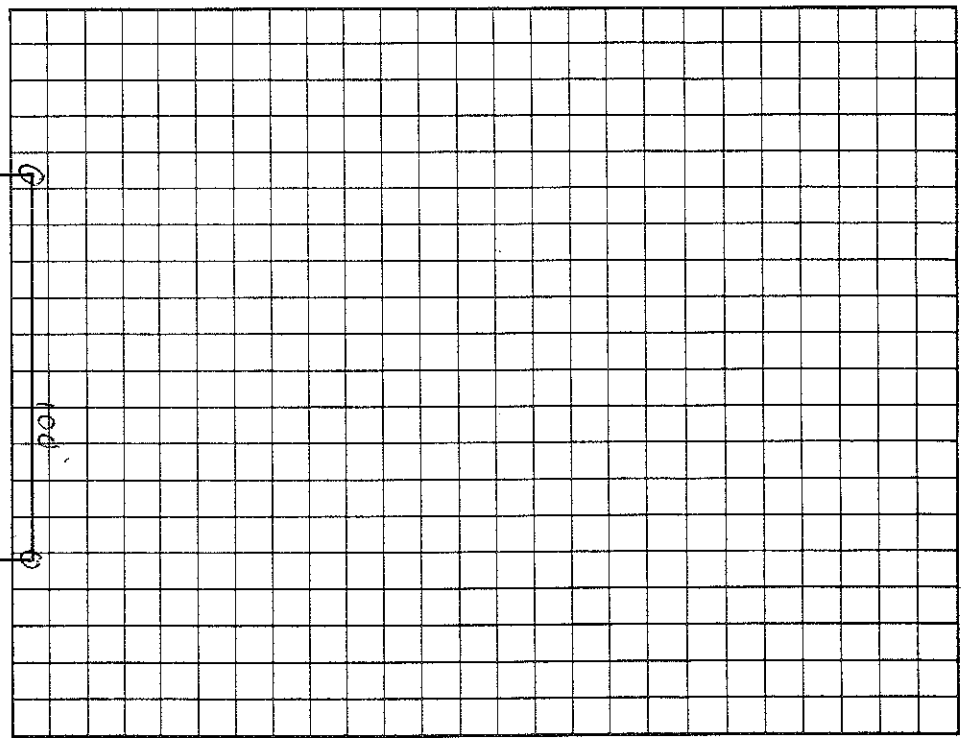

Permit can be suspended or revoked if any false information is supplied toward securing the permit/any unauthorized changes are made to the site/any unauthorized changes are made in the installation of the system. Improvement Permit with plat valid without expiration. Improvement Permit with site plan valid for sixty months. Authorization to Construct is valid for a period equal to that of Improvement Permit – not to exceed sixty months.

Signed: date

Improvement Permit by: RS date 9/3/03

Authorization to Construct by: RS date 12/3/03

Installed by: Corinthian Bldrs.

Operation Permit by: RS date 4/7/04

Existing System Inspection by: date

HEALTH DEPT. COPY: WHITE OWNER COPY (FINAL): YELLOW OWNER COPY (INITIAL): PINK