IREDELL COUNTY HEALTH DEPARTMENT

STATESVILLE 704-878-5605 MOORESVILLE 704-664-5281

IMPROVEMENT PERMIT / AUTHORIZATION TO CONSTRUCT / OPERATION PERMIT / EXISTING SYSTEM INSPECTION

PERMIT# 12896 PIN# ~~4649-05-5541.27~~ 4649-05-4650 760 DATE 9/3/03

OWNER OR CONTRACTOR CORINTHIAN DEVELOPERS LTD PHONE: Business 887-4697 Home

ADDRESS PO BOX 990 DENVER, NC 28037

LOCATION PERTH RD NORTH - TR GRAY CLIFF ON RT

SUBDIVISION GRAY CLIFF BLOCK / SECTION — LOT 27 LOT AREA .579AC SITE CLASS. AS DESIGN FLOW 360GPD L.T.A.R. .3600/AC

Septic Tank: 1000 Gallons; STB 794 Date 10/16/04

Pump Tank: Gallons; PT Date

Pump Make: Model Serial No.

Nitrification Field: No Fields 1 Square Feet ~~600~~ 430 Linear Feet 210

No Lines 6@35' Trench Width 24" Max Trench Bottom Depth 36" Gravel Depth N/A

☑ New System ☐ Repair System Type: I, II, (III), IV, V, VI

System Description: GRAVITY PANEL

Repair System Description: LP PANEL

Maintenance Agreement Required: ☐ Yes ☑ No

☑ ~~House~~/Mod. Home No. Bedrooms 3

☐ Mobile Home No. Bathrooms 3

☐ Business No. Employees

☐ Other


☐ Slab ☑ Crawl Space ☐ Basement w/plumbing ☐ Basement wo/plumbing

Water Supply: ☑ ~~Individual~~ ☐ Public ☐ Community


Comments:/Conditions:

Comments:/Conditions:

INITIAL SITE SKETCH 1"=50'

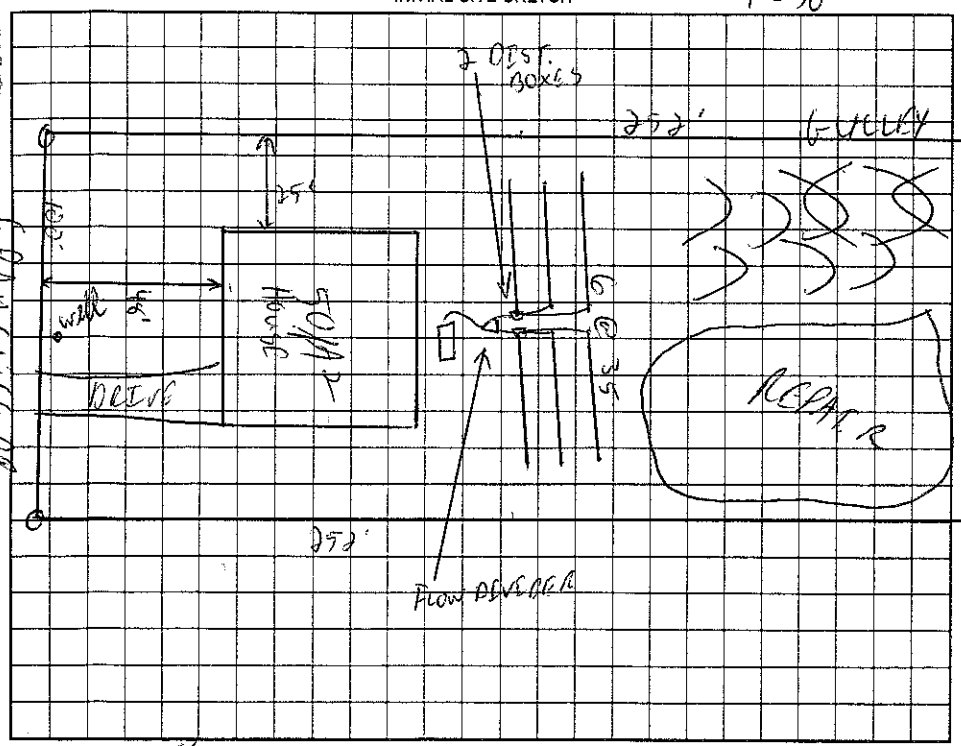

AS BUILT SKETCH

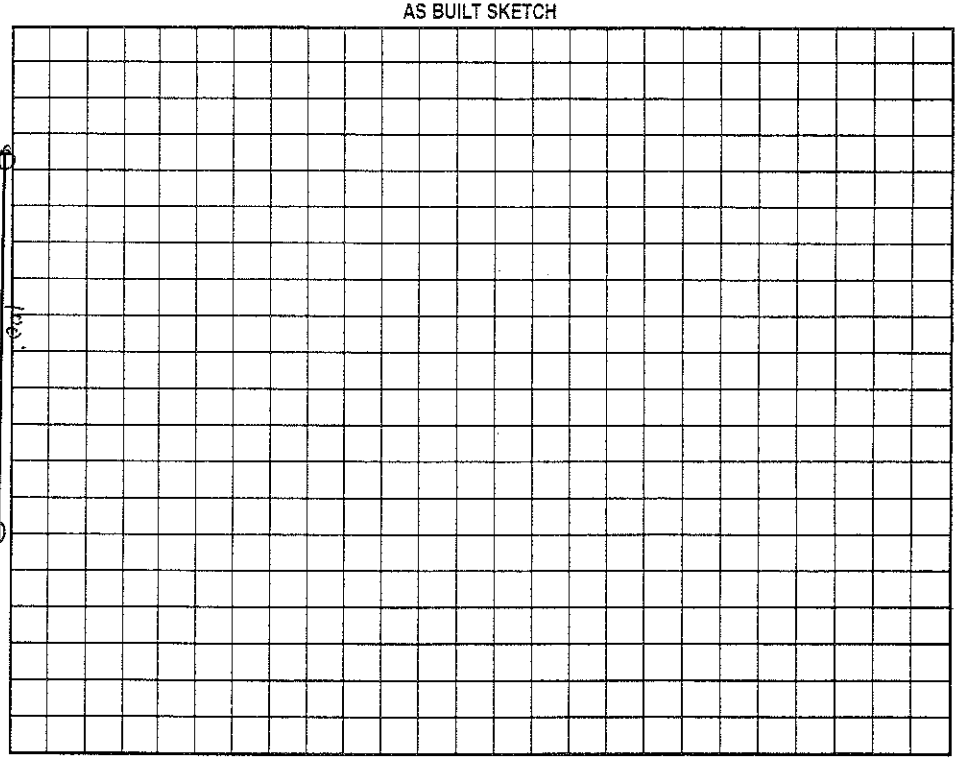

Permit can be suspended or revoked if any false information is supplied toward securing the permit/any unauthorized changes are made to the site/any unauthorized changes are made in the installation of the system. Improvement Permit with plat valid without expiration. Improvement Permit with site plan valid for sixty months. Authorization to Construct is valid for a period equal to that of Improvement Permit – not to exceed sixty months.

Signed: date

Improvement Permit by: RS date 9/3/03

Authorization to Construct by: RS date 8/19/04

Installed by: Corinthian Bldrs

Operation Permit by: RS date 1/13/05

Existing System Inspection by: date

HEALTH DEPT. COPY: WHITE OWNER COPY (FINAL): YELLOW OWNER COPY (INITIAL): PINK

Old Address: 132 Gray Cliff Dr.