IREDELL COUNTY HEALTH DEPARTMENT

STATESVILLE 704-878-5305 MOORESVILLE 704-664-5281

IMPROVEMENT PERMIT / AUTHORIZATION TO CONSTRUCT / OPERATION PERMIT / EXISTING SYSTEM INSPECTIC

PERMIT# 12897 PIN# ~~4649-05-5544.000~~ 4649-05-4861 DATE 9/3/03

OWNER OR CONTRACTOR CORINTHIAN DEVELOPERS, LTD PHONE: Business 827-9697 Home

ADDRESS PO BOX 990 DENVER, NC 28037

LOCATION PERTH NORTH - TR GRAYCLIFF - ON RT

SUBDIVISION GRAYCLIFF BLOCK / SECTION LOT 28 LOT AREA .579AC SITE CLASS RS DESIGN FLOW 360GPD L.T.A.R. .30-SD/F

Septic Tank: 1000 Gallons; STB 786 Date 4/24/04
Pump Tank: Gallons; PT Date
Pump Make: Model Serial No.
Nitrification Field: No Fields 1 Square Feet 400 Linear Feet 200
No Lines 4@50' Trench Width 24" Max Trench Bottom Depth 36" Gravel Depth n/a

☑ New System ☐ Repair System Type: I, II, (III), IV, V, VI
System Description: GRAVITY PANEL
Repair System Description: SAME
Maintenance Agreement Required: ☐ Yes ☑ No


☑ House/Mod. Home No. Bedrooms 3
☐ Mobile Home No. Bathrooms 3
☐ Business No. Employees
☐ Other
☐ Slab ☑ Crawl Space ☐ Basement w/plumbing ☐ Basement wo/plumbing

Water Supply:
☑ Individual
☐ Public
☐ Community


Comments:/Conditions:

Comments:/Conditions:

INITIAL SITE SKETCH 1"=50'

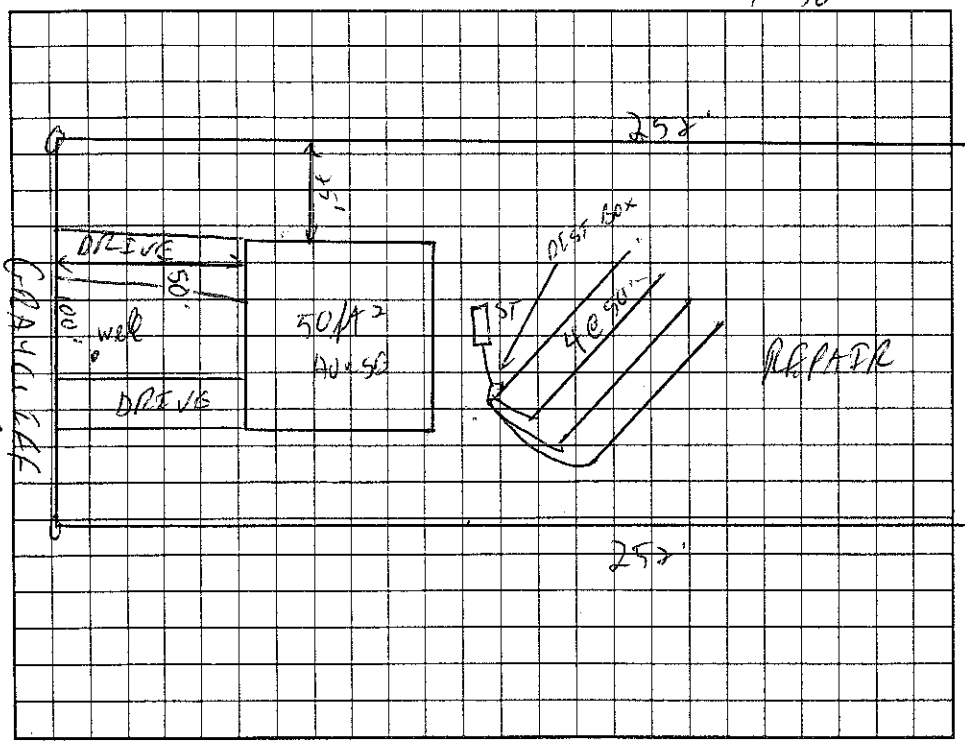

AS BUILT SKETCH

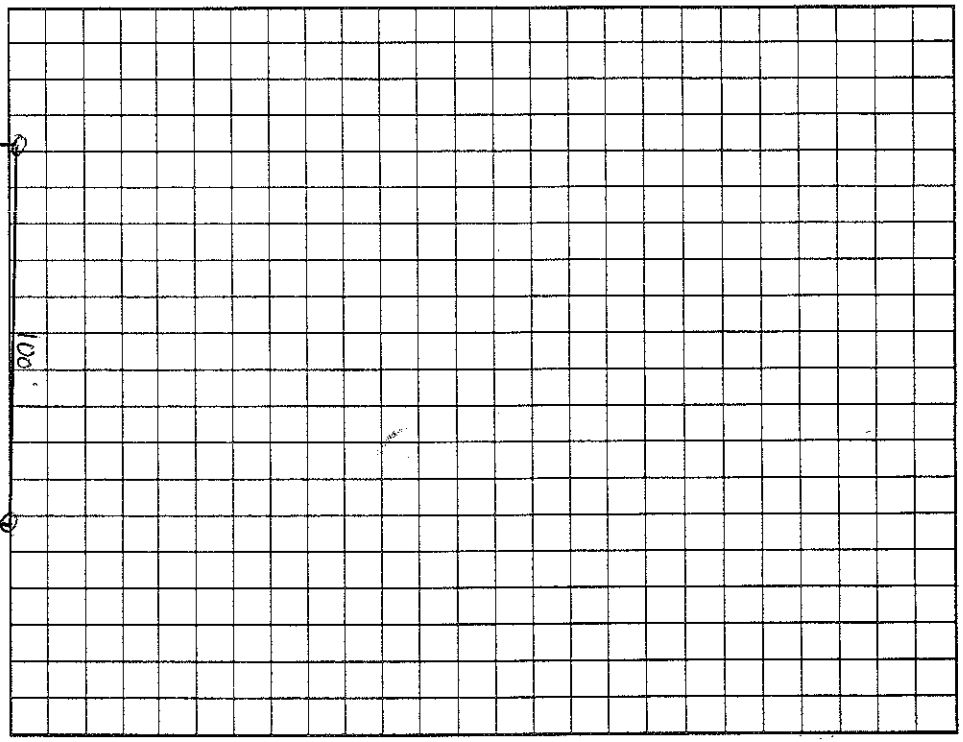

Permit can be suspended or revoked if any false information is supplied toward securing the permit/any unauthorized changes are made to the site/any unauthorized changes are made in the installation of the system. Improvement Permit with plat valid without expiration. Improvement Permit with site plan valid for sixty months. Authorization to Construct is valid for a period equal to that of Improvement Permit – not to exceed sixty months.

Signed: date

Improvement Permit by: RS date 9/3/03

Authorization to Construct by: RS date 4/20/04

Installed by: Corinthian Bldrs

Operation Permit by: RS date 7/27/04

Existing System Inspection by: date

HEALTH DEPT. COPY: WHITE OWNER COPY (FINAL): YELLOW OWNER COPY (INITIAL): PINK