IREDELL COUNTY HEALTH DEPARTMENT

STATESVILLE 704-878-5305 MOORESVILLE 704-664-5281

IMPROVEMENT PERMIT / AUTHORIZATION TO CONSTRUCT / OPERATION PERMIT / EXISTING SYSTEM INSPECTION

PERMIT# 112900 PIN# ~~4649 05 5541. 29~~ 4649-05-5922 DATE 5/6/04

OWNER OR CONTRACTOR CORINTHIAN DEVELOPERS PHONE: Business 400-1258 Home

ADDRESS PO BOX 990 DENVER NC 28037

LOCATION PEARTH (N) - TR GRAYCLIFF - ON RT

SUBDIVISION GRAY CLIFF BLOCK / SECTION LOT 29 LOT AREA .599AC SITE CLASS. PS DESIGN FLOW 360GPD L.T.A.R. .36PD/FT²

Septic Tank: 1000 Gallons; STB FTB10 Date 04/01/04
Pump Tank: Gallons; PT Date
Pump Make: Model Serial No.
Nitrification Field: No Fields 1 Square Feet 400 Linear Feet 200
No Lines 4@50' Trench Width 24" Max Trench Bottom Depth 36" Gravel Depth N/A

☑ New System ☐ Repair System Type: I, II, III, IV, V, VI
System Description: GRAVITY PANEL
Repair System Description: LP PANEL
Maintenance Agreement Required: ☐ Yes ☑ No


☑ House/Mod. Home No. Bedrooms 3
☐ Mobile Home No. Bathrooms 3
☐ Business No. Employees
☐ Other
☐ Slab ☑ Crawl Space ☐ Basement w/plumbing ☐ Basement wo/plumbing

Water Supply: ☑ Individual ☐ Public ☐ Community

Comments:/Conditions:

Comments:/Conditions:

INITIAL SITE SKETCH

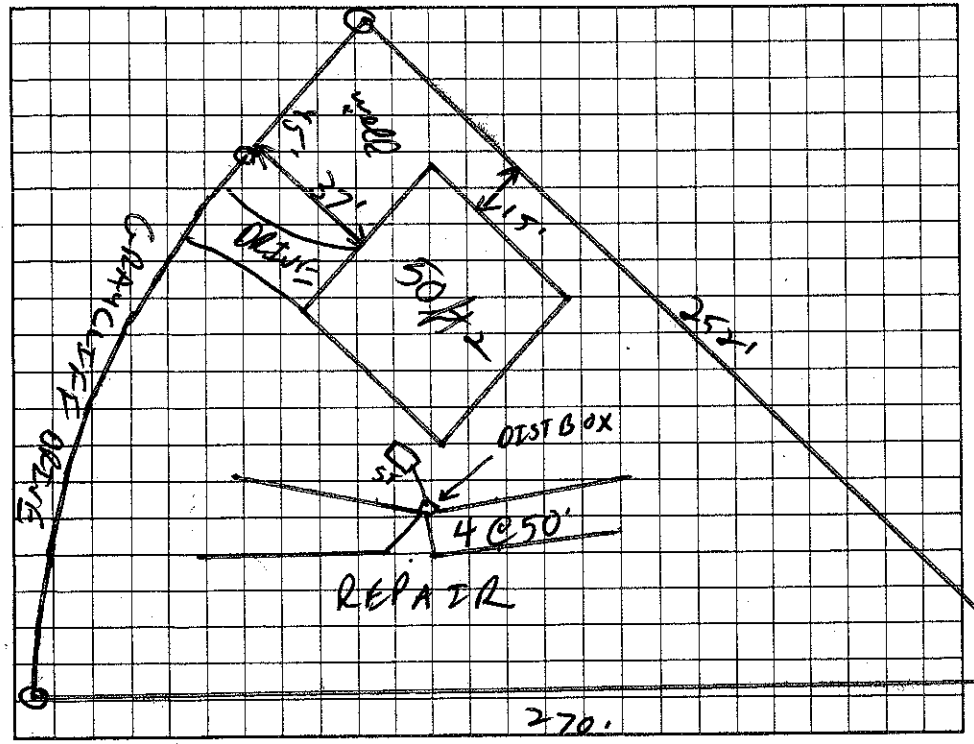

AS BUILT SKETCH

Permit can be suspended or revoked if any false information is supplied toward securing the permit/any unauthorized changes are made to the site/any unauthorized changes are made in the installation of the system. Improvement Permit with plat valid without expiration. Improvement Permit with site plan valid for sixty months. Authorization to Construct is valid for a period equal to that of Improvement Permit – not to exceed sixty months.

Signed: date 6-11-04 Installed by: Foundation Development

Improvement Permit by: CS date 5/6/04 Operation Permit by: Wesley Sparks R.S. date 8/24/04

Authorization to Construct by: CS date 6/11/04 Existing System Inspection by: date

HEALTH DEPT. COPY: WHITE OWNER COPY (FINAL): YELLOW OWNER COPY (INITIAL): PINK