IREDELL COUNTY HEALTH DEPARTMENT

STATESVILLE 704-878-5305 MOORESVILLE 704-664-5281

IMPROVEMENT PERMIT / AUTHORIZATION TO CONSTRUCT / OPERATION PERMIT / EXISTING SYSTEM INSPECTION

PERMIT# 112920 PIN# 4649055641.15 4649-05-7011 DATE 9/3/03

OWNER OR CONTRACTOR CORINTHIAN DEVELOPERS PHONE: Business 8279697 Home

ADDRESS PO BOX 990 DENVER NC 28037

LOCATION PERTH RD NORTH - TR GRAYCLIFF ON LT

SUBDIVISION GRAYCLIFF BLOCK / SECTION LOT 15 LOT AREA SITE CLASS. PS DESIGN FLOW 360 GPD L.T.A.R. .3600 GPD

Septic Tank: 1000 Gallons; STB 786 Date 7/4/03
Pump Tank: 1000 Gallons; PT 40 Date 9/4/03
Pump Make: Model Serial No.
Nitrification Field: No Fields 1 Square Feet 900 Linear Feet 300
No Lines 3@100' Trench Width 36" Max Trench Bottom Depth 36" Gravel Depth N/A

☑ New System ☐ Repair System Type: I, II, III, IV, V, VI
System Description: PUMP 25% REDUCTION
Repair System Description: PUMP PANEL
Maintenance Agreement Required: ☐ Yes ☑ No


☐ House/Mod. Home No. Bedrooms 3
☐ Mobile Home No. Bathrooms 3
☐ Business No. Employees
☐ Other
☐ Slab ☑ Crawl Space ☐ Basement w/plumbing ☐ Basement wo/plumbing

Water Supply: ☑ Individual ☐ Public ☐ Community

Comments:/Conditions:

Comments:/Conditions:

INITIAL SITE SKETCH 1" = 50'

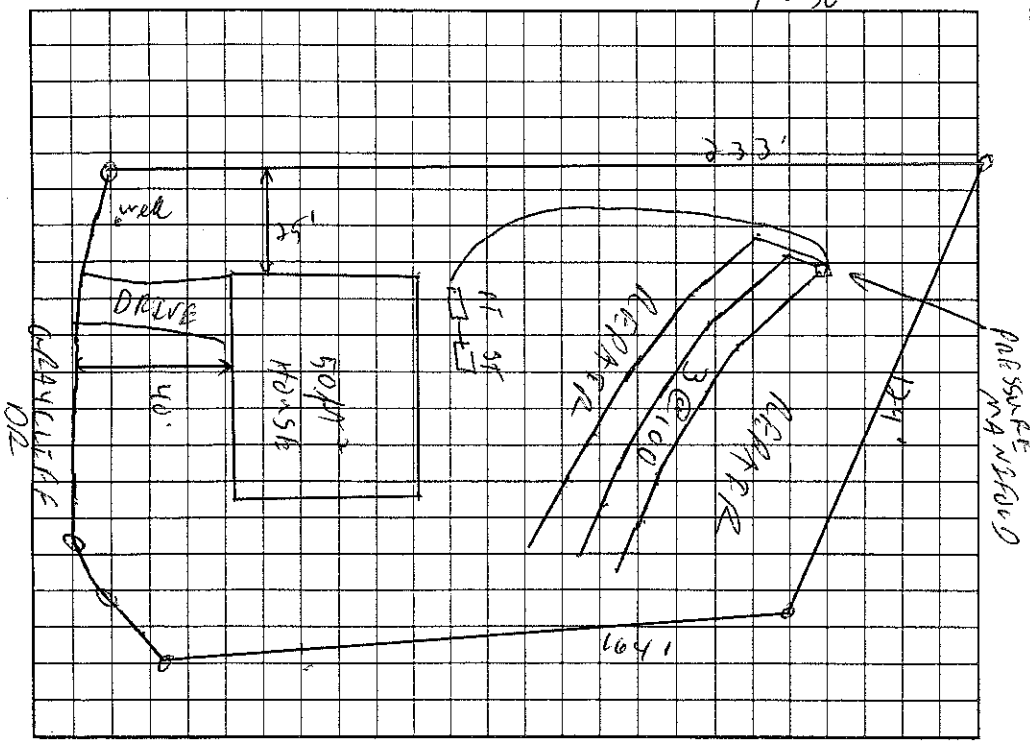

AS BUILT SKETCH

EZ Flow Installed AS DRAWN

Permit can be suspended or revoked if any false information is supplied toward securing the permit/any unauthorized changes are made to the site/any unauthorized changes are made in the installation of the system. Improvement Permit with plat valid without expiration. Improvement Permit with site plan valid for sixty months. Authorization to Construct is valid for a period equal to that of Improvement Permit – not to exceed sixty months.

Signed: date

Improvement Permit by: RS date 9/3/03

Authorization to Construct by: RS date 9/23/03

Installed by: Corinthian Builders

Operation Permit by: RS date 1/12/03

Existing System Inspection by: date

HEALTH DEPT. COPY: WHITE OWNER COPY (FINAL): YELLOW OWNER COPY (INITIAL): PINK