IREDELL COUNTY HEALTH DEPARTMENT

STATESVILLE 704-878-5305 MOORESVILLE 704-664-5281

IMPROVEMENT PERMIT / AUTHORIZATION TO CONSTRUCT / OPERATION PERMIT / EXISTING SYSTEM INSPECTION

PERMIT# 123177 PIN# 4649-05-7123 DATE 10/13/04

OWNER OR CONTRACTOR Corinthian Builders PHONE: Business _____ Home 704 664-4822

ADDRESS PO Box 990 Denver NC [redacted]

LOCATION Perth Rd N, TR Graycliff on Lt.

SUBDIVISION Graycliff BLOCK / SECTION _____ LOT 14 LOT AREA _____ SITE CLASS. PS DESIGN FLOW 360 L.T.A.R. 0.3

Septic Tank: Existing Gallons; STB _____ Date _____

Pump Tank: Existing Gallons; PT _____ Date _____

Pump Make: Existing Model _____ Serial No. _____

Nitrification Field: No Fields 1 Square Feet 600 Linear Feet 200

No Lines 2@100' Trench Width 36" Max Trench Bottom Depth 36" Gravel Depth —

☒ New System ☐ Repair System Type: I, II, III, IV, V, VI

System Description: LP Panel Block

Repair System Description: Same

Maintenance Agreement Required: ☒ Yes ☐ No

☐ House/Mod. Home No. Bedrooms ____

☐ Mobile Home No. Bathrooms ____

☐ Business No. Employees ____

☒ Other Detached Garage


☒ Slab ☐ Crawl Space ☐ Basement w/plumbing ☐ Basement wo/plumbing

Water Supply: ☒ Individual ☐ Public ☐ Community

Comments:/Conditions: * Garage Addition stated on Existing Drainfield. The drainfield had not been used. Remove Drainfield material in upper Existing Line and replace with Panel Block - 1 New Line

Comments:/Conditions: Drainfield material will need to be removed from other Existing line and Panel-Block added back for repair when needed

INITIAL SITE SKETCH

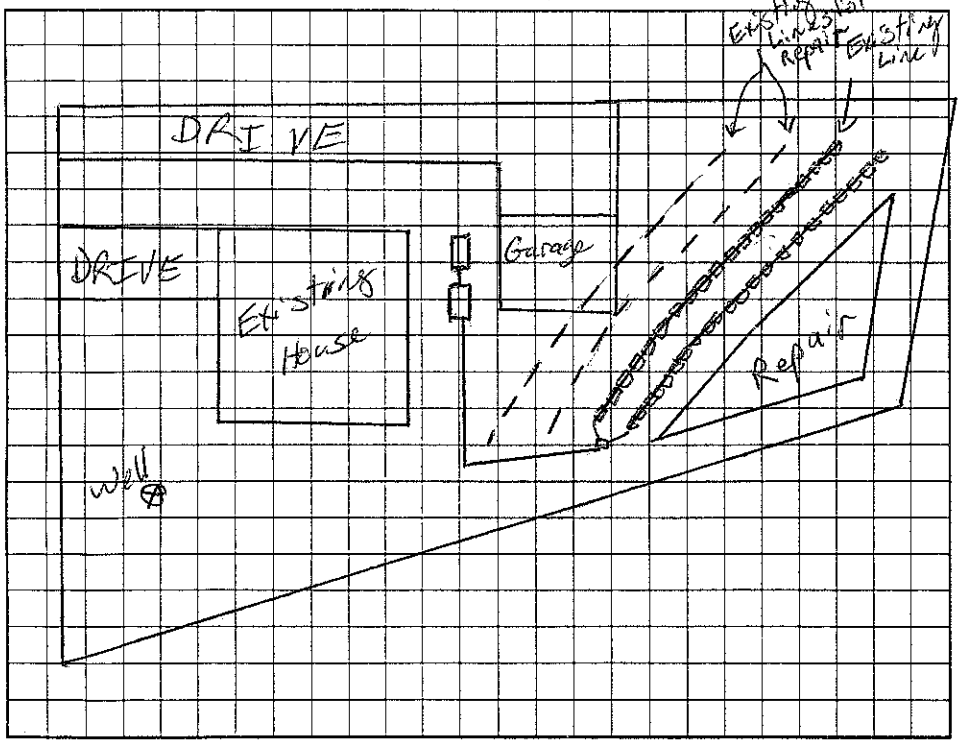

AS BUILT SKETCH

The New Panel Line will need to be 36" Trench width to match the Existing Trench Width.

Installed As Drawn

46 Panels 3/16" holes

Permit can be suspended or revoked if any false information is supplied toward securing the permit/any unauthorized changes are made to the site/any unauthorized changes are made in the installation of the system. Improvement Permit with plat valid without expiration. Improvement Permit with site plan valid for sixty months. Authorization to Construct is valid for a period equal to that of Improvement Permit – not to exceed sixty months.

Signed: _____ date _____ Installed by: Corinthian Bldrs

Improvement Permit by: RS date 10/13/04 Operation Permit by: RS date 11/9/04

Authorization to Construct by: RS date 10/13/04 Existing System Inspection by: _____ date _____

HEALTH DEPT. COPY: WHITE OWNER COPY (FINAL): YELLOW OWNER COPY (INITIAL): PINK