IREDELL COUNTY HEALTH DEPARTMENT

STATESVILLE 704-878-5305 130.00 Paid MOORESVILLE 704-664-5281

IMPROVEMENT PERMIT / AUTHORIZATION TO CONSTRUCT / OPERATION PERMIT / EXISTING SYSTEM INSPECTION

PERMIT# 1179-8 12487 PIN# 4649055644.14 DATE 11/17/03

OWNER OR CONTRACTOR CORINTHIAN DEVELOPERS PHONE: Business 827-9697 Home

ADDRESS PO Box 990 DENVER NC 28037

LOCATION PERTH (N) - IR CRAYCLEFF - ON LT

SUBDIVISION CRAYCLEFF BLOCK / SECTION I LOT 14 LOT AREA . SITE CLASS. RS DESIGN FLOW 360GPD L.T.A.R. .3660/KR

Septic Tank: 1000 Gallons; STB 756 Date 3/27/04
Pump Tank: 1000 Gallons; PT 37 Date 3/27/04
Pump Make: MYERS Model ME-100 Serial No.
Nitrification Field: No Fields 1 Square Feet 900 Linear Feet 300
No Lines 3 @ 100' Trench Width 36" Max Trench Bottom Depth 36" Gravel Depth N/A

☑ New System ☐ Repair System Type: I, II, III, IV, V, VI
System Description: Pump 25% REDUCTION
Repair System Description: LP PANEL
Maintenance Agreement Required: ☐ Yes ☑ No

☑ House/Mod. Home No. Bedrooms 3
☐ Mobile Home No. Bathrooms 2
☐ Business No. Employees
☐ Other


☐ Slab ☐ Crawl Space ☐ Basement w/plumbing ☐ Basement wo/plumbing

Water Supply: ☐ Individual ☐ Public ☐ Community

Comments:/Conditions:

Comments:/Conditions:

INITIAL SITE SKETCH 1"=50'

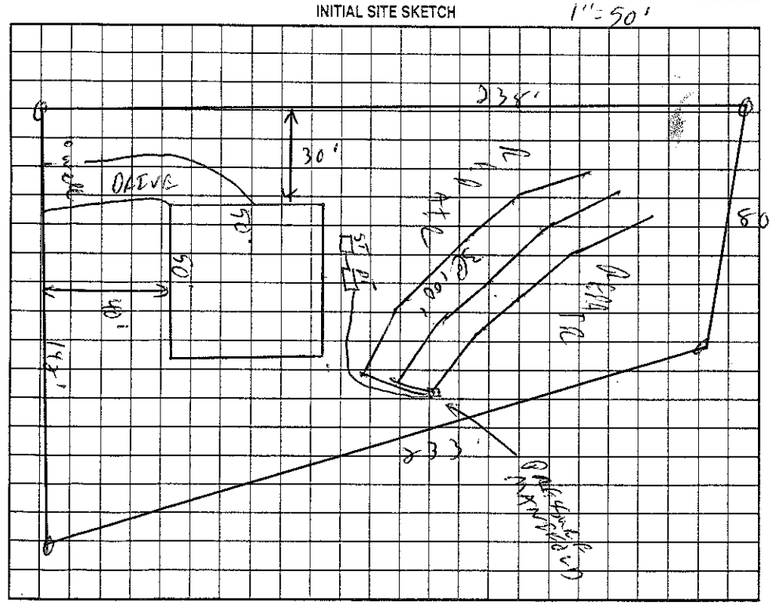

AS BUILT SKETCH

Permit can be suspended or revoked if any false information is supplied toward securing the permit/any unauthorized changes are made to the site/any unauthorized changes are made in the installation of the system. Improvement Permit with plat valid without expiration. Improvement Permit with site plan valid for sixty months. Authorization to Construct is valid for a period equal to that of Improvement Permit – not to exceed sixty months.

Signed: date 12-5-03 Installed by: Corinthian Development

Improvement Permit by: RS date 11/17/03 Operation Permit by: Wesley Sparks RS. date 8/26/04

Authorization to Construct by: RS date 5/25/04 Existing System Inspection by: date

HEALTH DEPT. COPY: WHITE OWNER COPY (FINAL): YELLOW OWNER COPY (INITIAL): PINK