IREDELL COUNTY HEALTH DEPARTMENT

STATESVILLE 704-878-5305 130.00 Paid MOORESVILLE 704-664-5281

IMPROVEMENT PERMIT / AUTHORIZATION TO CONSTRUCT / OPERATION PERMIT / EXISTING SYSTEM INSPECTION

PERMIT# 112887 PIN# 4649 05 5641.15 4649-05-7233 DATE 11/6/03

OWNER OR CONTRACTOR CORINTHIAN DEVELOPERS / DAN WEST PHONE: Business 827-9697 Home

ADDRESS PO BOX 990 DENVER NC 28037

LOCATION PERTH (N) - TR GRAYCLIFF - ON LT

SUBDIVISION GRAYCLIFF BLOCK / SECTION LOT 13 LOT AREA .599 Ac SITE CLASS. PS DESIGN FLOW 360 GPD L.T.A.R. .36 GPD/FT²

Septic Tank: 1000 Gallons; STB 317 Date 1/24/04
Pump Tank: 1000 Gallons; PT 283 Date 2/24/04
Pump Make: Liberty Model 283 Serial No.
Nitrification Field: No Fields 1 Square Feet 900 Linear Feet 300
No Lines 3 @ 100' Trench Width 36" Max Trench Bottom Depth ~~24~~ 30" Gravel Depth N/A

☑ New System ☐ Repair System Type: I, II, (III) IV, V, VI
System Description: PUMP 25% REDUCTION
Repair System Description: LP PANEL
Maintenance Agreement Required: ☐ Yes ☑ No


☑ House/Mod. Home No. Bedrooms 3
☐ Mobile Home No. Bathrooms 3
☐ Business No. Employees
☐ Other
☐ Slab ☑ Crawl Space ☐ Basement w/plumbing ☐ Basement wo/plumbing

Water Supply: ☑ Individual ☐ Public ☐ Community


Comments:/Conditions:

Comments:/Conditions:

INITIAL SITE SKETCH 1" = 50'

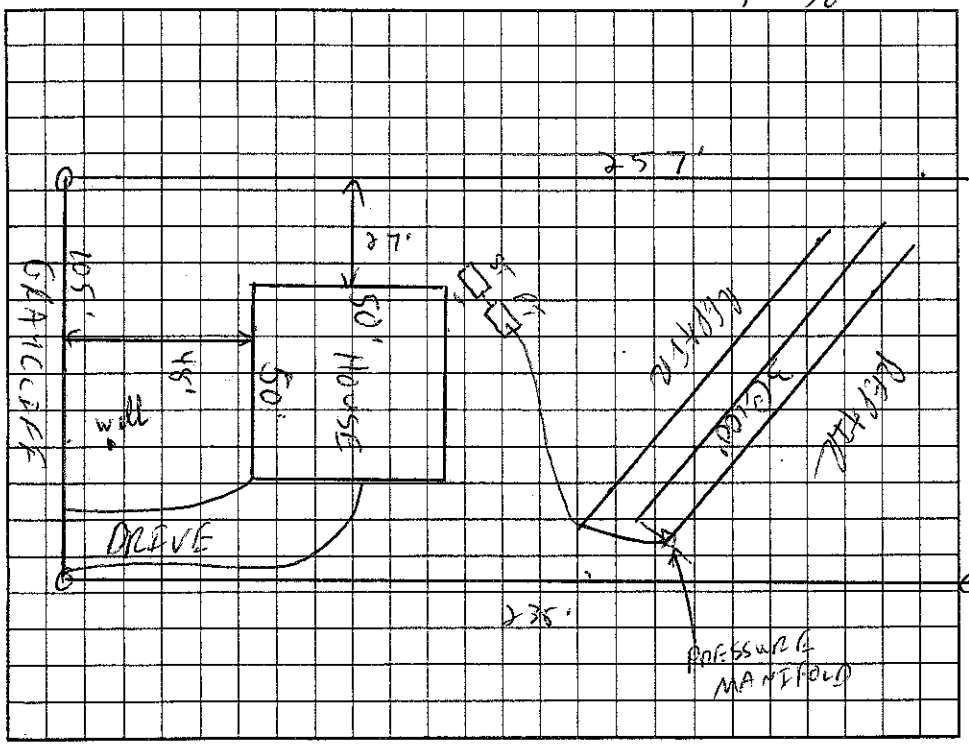

AS BUILT SKETCH

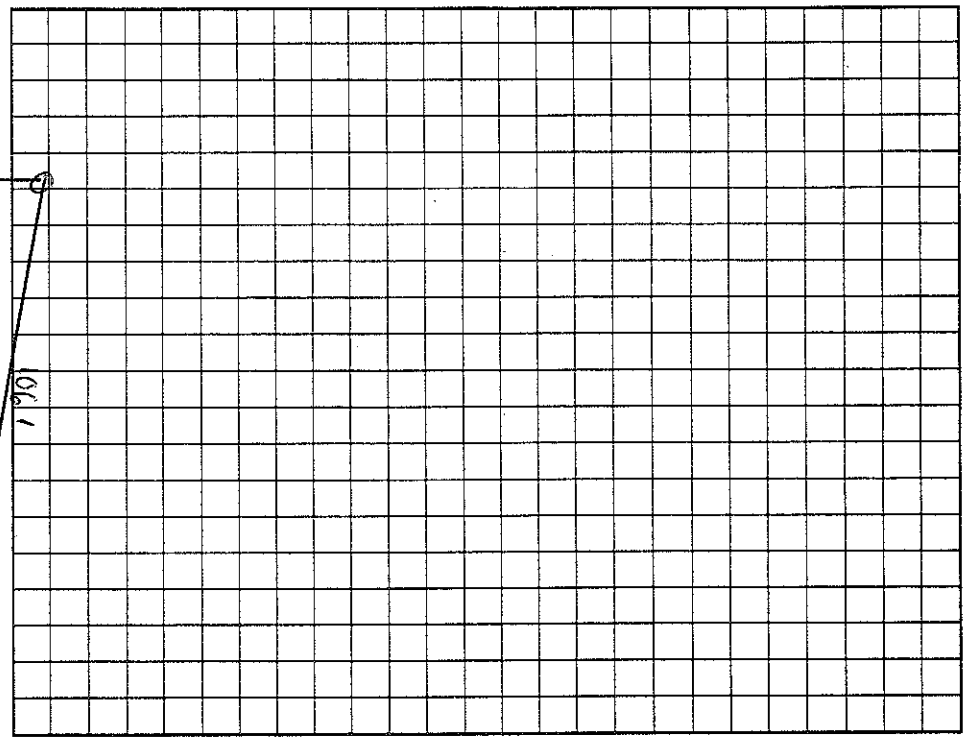

Permit can be suspended or revoked if any false information is supplied toward securing the permit/any unauthorized changes are made to the site/any unauthorized changes are made in the installation of the system. Improvement Permit with plat valid without expiration. Improvement Permit with site plan valid for sixty months. Authorization to Construct is valid for a period equal to that of Improvement Permit – not to exceed sixty months.

Signed: date 11-14-03 Installed by: Harris Grading

Improvement Permit by: C. Hyde RS date 11/6/03 Operation Permit by: RS date 8/31/04

Authorization to Construct by: C. Hyde RS date 11/17/03 Existing System Inspection by: date

HEALTH DEPT. COPY: WHITE OWNER COPY (FINAL): YELLOW OWNER COPY (INITIAL): PINK