IREDELL COUNTY HEALTH DEPARTMENT

STATE 704-878-5305 Paid MOORESVILLE 704-664-5281

IMPROVEMENT PERMIT / AUTHORIZATION TO CONSTRUCT / OPERATION ... IT / EXISTING SYSTEM INSPECTION

PERMIT# 112895 PIN# 4649055641 .12 4649057344 DATE 1/6/05

OWNER OR CONTRACTOR Neighborhood Community Homes, PHONE: Business 704-622-0065 Home

ADDRESS PO Box 4358 Davidson NC 28036

LOCATION Perth Rd N, TR Graycliff, on Lt

SUBDIVISION Graycliff BLOCK / SECTION LOT 12 LOT AREA SITE CLASS. PS DESIGN FLOW 360 L.T.A.R. 0.3

Septic Tank: 1000 Gallons; STB 794 Date 10/24/04
Pump Tank: 1000 Gallons; PT 285 Date 10/24/04
Pump Make: Liberty Model 285 Serial No.
Nitrification Field: No Fields 1 Square Feet 400 Linear Feet 300
No Lines 4@75' Trench Width 36" Max Trench Bottom Depth 36" Gravel Depth —

☒ New System ☐ Repair System Type: I, II, (III), IV, V, VI
System Description: Pump 25% Reduction
Repair System Description: Same
Maintenance Agreement Required: ☐ Yes ☒ No

☒ House/Mod. Home No. Bedrooms 3
☐ Mobile Home No. Bathrooms
☐ Business No. Employees
☐ Other


☐ Slab ☒ Crawl Space ☐ Basement w/plumbing ☐ Basement wo/plumbing

Water Supply: ☒ Individual ☐ Public ☐ Community


Comments:/Conditions:

Comments:/Conditions:
Tanks, Lines, + pressure OK-GM

INITIAL SITE SKETCH

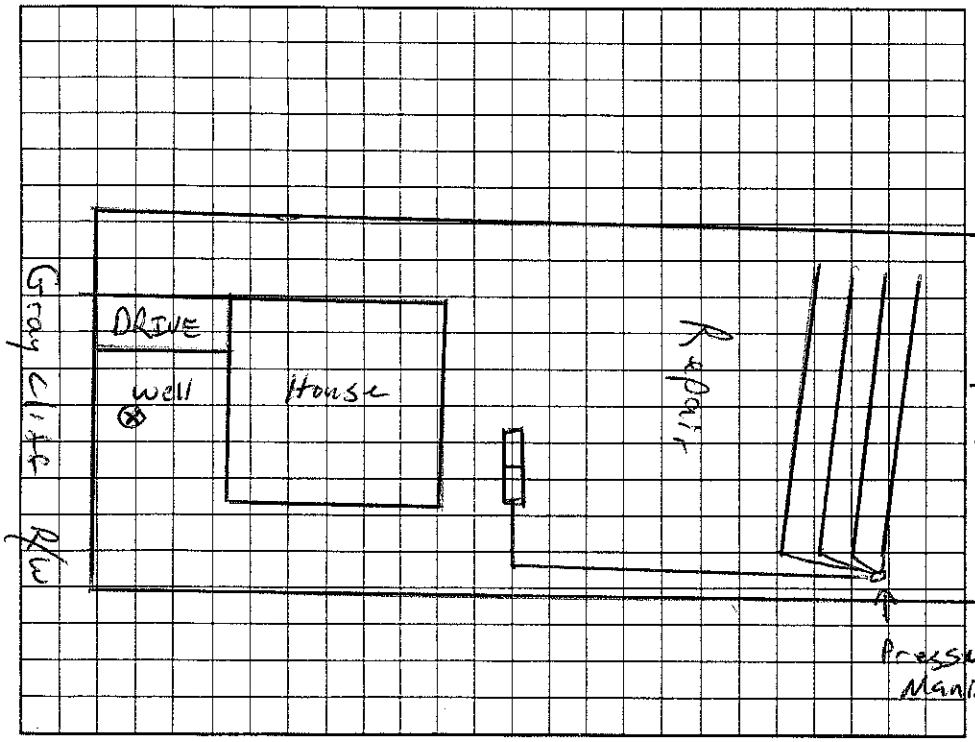

AS BUILT SKETCH

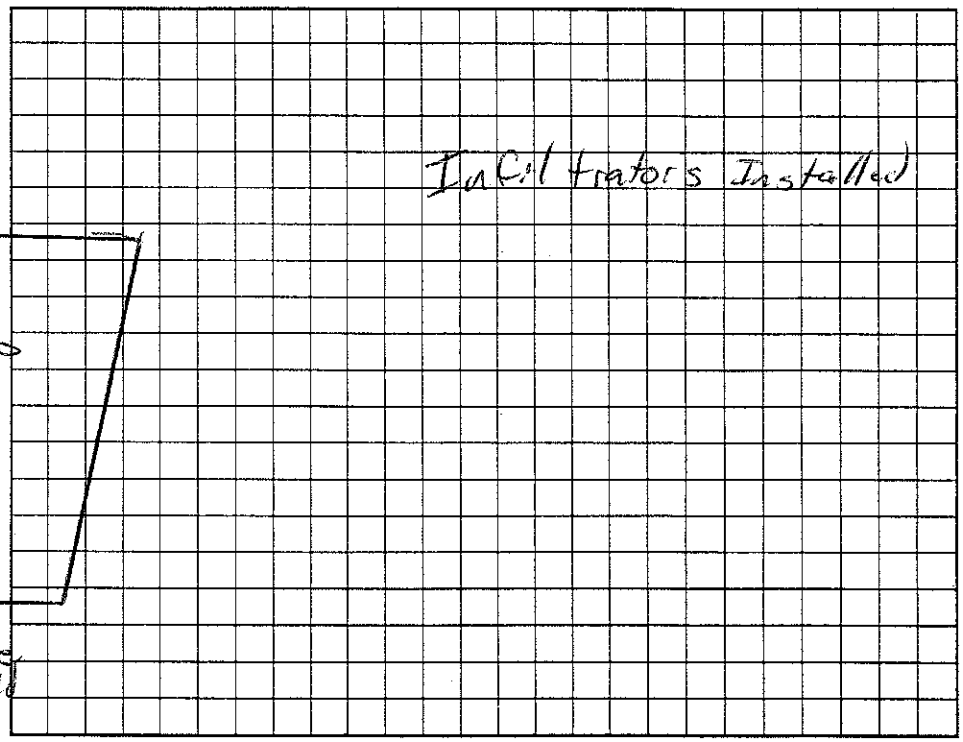

Permit can be suspended or revoked if any false information is supplied toward securing the permit/any unauthorized changes are made to the site/any unauthorized changes are made in the installation of the system. Improvement Permit with plat valid without expiration. Improvement Permit with site plan valid for sixty months. Authorization to Construct is valid for a period equal to that of Improvement Permit – not to exceed sixty months.

Signed: Daniel J. West, President, NCH, Inc. date 2/15/05
Improvement Permit by: RS date 1/6/05
Authorization to Construct by: RS date 1/6/05

Installed by: Joe Harris
Operation Permit by: RS date 2/16/05
Existing System Inspection by: date

HEALTH DEPT. COPY: WHITE OWNER COPY (FINAL): YELLOW OWNER COPY (INITIAL): PINK