IREDELL COUNTY HEALTH DEPARTMENT

STATESVILLE 704-878-5305 MOORESVILLE 704-664-5281

IMPROVEMENT PERMIT / AUTHORIZATION TO CONSTRUCT / OPERATION PERMIT / EXISTING SYSTEM INSPECTION

PERMIT# 112883 PIN# 4649055641.11 4649-05-7463 DATE 8/4/03

OWNER OR CONTRACTOR CORINTHIAN DEV. CO.

ADDRESS PO BOX 990 OWNER #: 28037 PHONE: Business 827-9697 Home

LOCATION PERTH (N) - TR GRAYCLIFF - ON LT

SUBDIVISION GRAYCLIFF BLOCK / SECTION LOT 11 LOT AREA .653AC SITE CLASS. RS DESIGN FLOW 360GPD L.T.A.R. 360 GPD

Septic Tank: 1000 Gallons; STB 784 Date 11/4/04

Pump Tank: 1000 Gallons; PT 32 Date 11/4/04

Pump Make: Myers Model Mes 5-21 Serial No.

Nitrification Field: No Fields 1 Square Feet 400 Linear Feet 200

No Lines 4@50' Trench Width 24" Max Trench Bottom Depth 36" Gravel Depth N/A

☑ New System ☐ Repair System Type: I, II, III, IV, V, VI

System Description: PUMP PANEL

Repair System Description: 800 LP PANEL

Maintenance Agreement Required: ☐ Yes ☑ No

☑ House/Mod. Home No. Bedrooms 3

☐ Mobile Home No. Bathrooms 3

☐ Business No. Employees

☐ Other


☐ Slab ☑ Crawl Space ☐ Basement w/plumbing ☐ Basement wo/plumbing

Water Supply: ☑ Individual ☐ Public ☐ Community


Comments:/Conditions:

Comments:/Conditions:

INITIAL SITE SKETCH 1"=50'

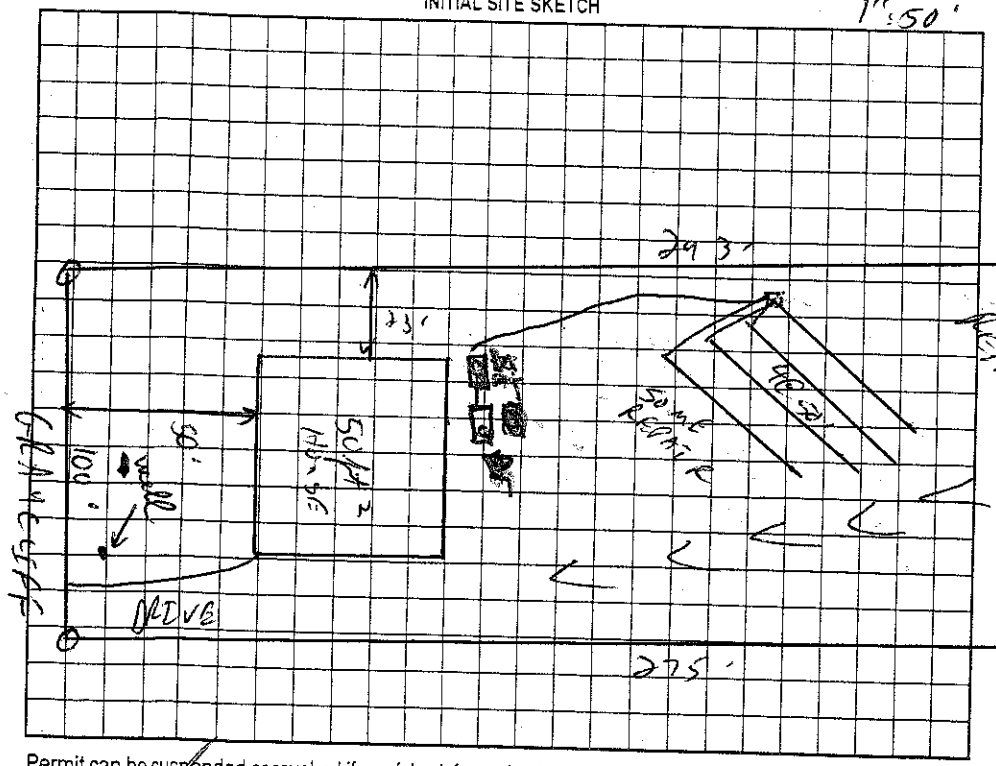

AS BUILT SKETCH

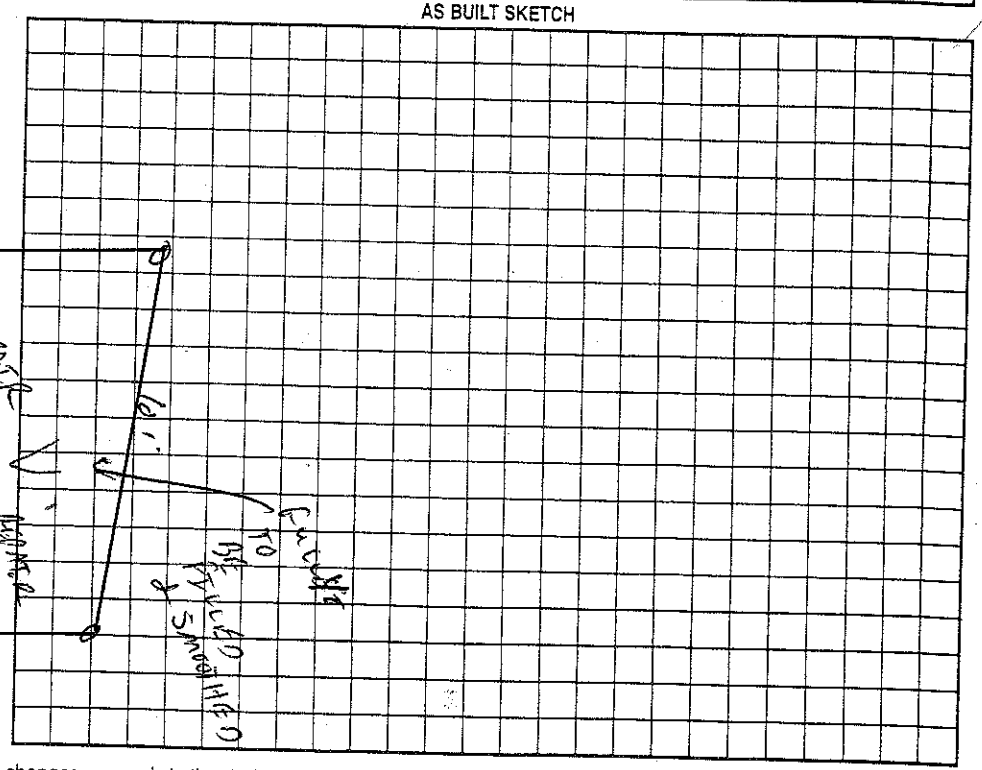

Permit can be suspended or revoked if any false information is supplied toward securing the permit/any unauthorized changes are made to the site/any unauthorized changes are made in the installation of the system. Improvement Permit with plat valid without expiration. Improvement Permit with site plan valid for sixty months. Authorization to Construct is valid for a period equal to that of Improvement Permit – not to exceed sixty months.

Signed: date 8/11/03 Installed by: Corinthian

Improvement Permit by: RS date 8/4/03 Operation Permit by: Wesley Sparks RS. date 5/12/04

Authorization to Construct by: RS date 2/5/04 Existing System Inspection by: date

HEALTH DEPT. COPY: WHITE OWNER COPY (FINAL): YELLOW OWNER COPY (INITIAL): PINK