IREDELL COUNTY HEALTH DEPARTMENT

STATESVILLE 704-878-5305 MOORESVILLE 704-664-5281

IMPROVEMENT PERMIT / AUTHORIZATION TO CONSTRUCT / OPERATION PERMIT / EXISTING SYSTEM INSPECTION

11:00

PERMIT# 11285! PIN# 4649 05 5641.10 4649-05-7564 DATE 8/4/03

OWNER OR CONTRACTOR CORINTHIAN DEVELOPMENT PHONE: Business 827-9697 Home

ADDRESS PO Box 990 DENVER NC 28037

LOCATION PERTH RD (N) - TR GRAYCLIFF - ON LT

SUBDIVISION GRAYCLIFF BLOCK / SECTION LOT 10 LOT AREA .686AC SITE CLASS RS DESIGN FLOW 360GPD L.T.A.R. .360/KFT²

Septic Tank: 1000 Gallons; STB 786 Date 7/7/05

Pump Tank: 1000 Gallons; PT 40 Date 8/6/03

Pump Make: Myers Model ME50S-½ Serial No.

Nitrification Field: No Fields 1 Square Feet 900 Linear Feet 300

No Lines 4@75 Trench Width 36" Max Trench Bottom Depth 36" Gravel Depth N/A

☑ New System ☐ Repair System Type: I, II, III, IV, V, VI

System Description: Pump 25% Reduction

Repair System Description: SAME

Maintenance Agreement Required: ☐ Yes ☑ No

☑ House/Mod. Home No. Bedrooms 3

☐ Mobile Home No. Bathrooms 3

☐ Business No. Employees

☐ Other

☐ Slab ☑ Crawl Space ☐ Basement w/plumbing ☐ Basement wo/plumbing


Water Supply: ☑ Individual ☐ Public ☐ Community

Comments:/Conditions:


Comments:/Conditions:

o well

INITIAL SITE SKETCH 1" = 50'

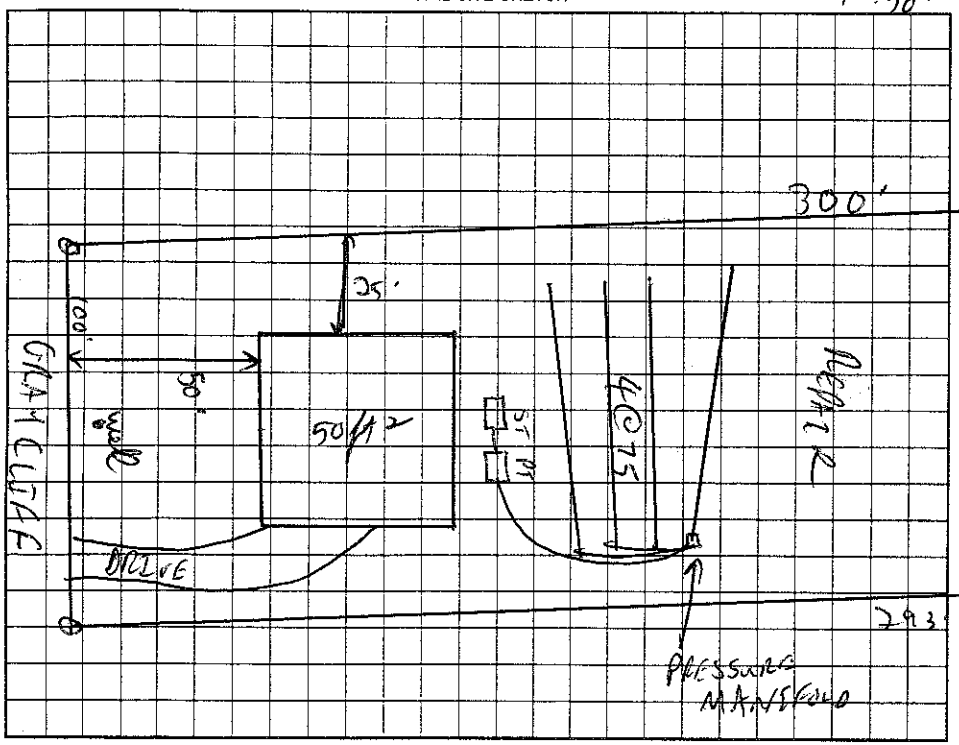

AS BUILT SKETCH

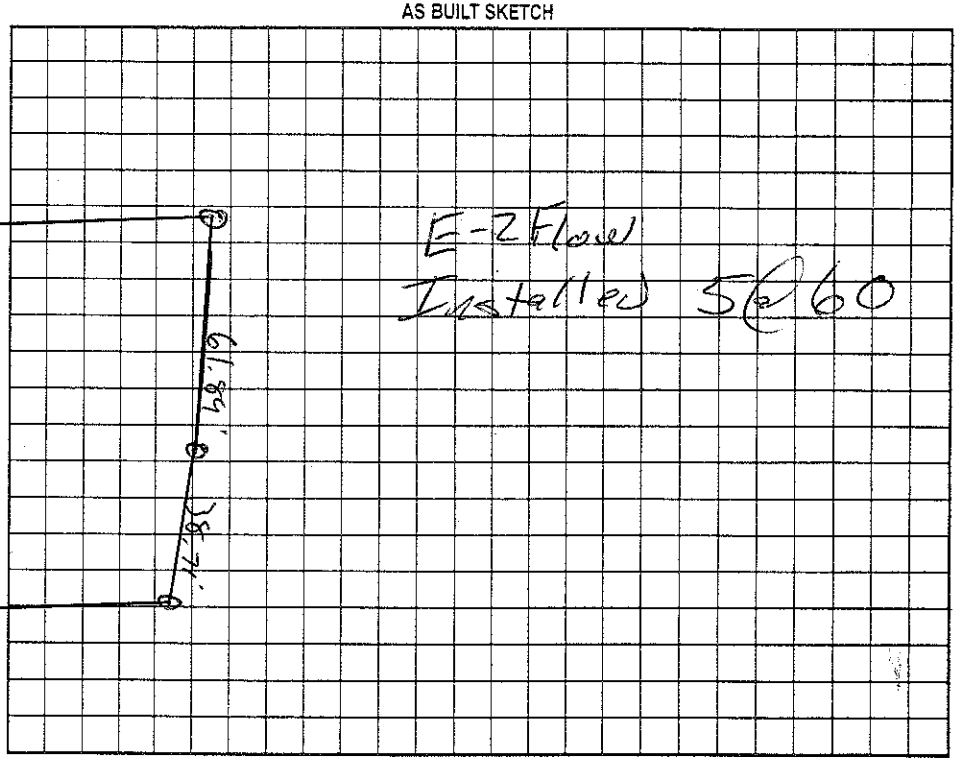

Permit can be suspended or revoked if any false information is supplied toward securing the permit/any unauthorized changes are made to the site/any unauthorized changes are made in the installation of the system. Improvement Permit with plat valid without expiration. Improvement Permit with site plan valid for sixty months. Authorization to Construct is valid for a period equal to that of Improvement Permit – not to exceed sixty months.

Signed: date 8/11/03 Installed by: Corinthian Developers

Improvement Permit by: RS date 8/4/03 Operation Permit by: RS date 10/9/03

Authorization to Construct by: RS date 8/7/03 Existing System Inspection by: date

HEALTH DEPT. COPY: WHITE OWNER COPY (FINAL): YELLOW OWNER COPY (INITIAL): PINK