Called in 12/15/03

IREDELL COUNTY HEALTH DEPARTMENT

STATESVILLE 704-878-5305 MOORESVILLE 704-664-5281

IMPROVEMENT PERMIT / AUTHORIZATION TO CONSTRUCT / OPERATION PERMIT / EXISTING SYSTEM INSPECTION

PERMIT# 12850 PIN# 4649055641.09 4649-05-7674 DATE 8/4/03

OWNER OR CONTRACTOR CORINTHIAN DEVELOPMENT / RION BLDRS PHONE: Business 827-9697 Home

ADDRESS PO BOX 990 DENVER NC 28037 / 135 GREYCLIFF

LOCATION PERTH RD (N) - TR GRAYCLIFF - ON LT

SUBDIVISION GRAYCLIFF BLOCK / SECTION LOT 9 LOT AREA 30,000 SITE CLASS PS DESIGN FLOW 360 L.T.A.R. .36 / F2

Septic Tank: 1000 Gallons; STB 1007 Date 8/29/03
Pump Tank: 1000 Gallons; PT 274 Date 8/14/03
Pump Make: ZOELLER Model N-152 Serial No. 0903
Nitrification Field: No Fields 1 Square Feet 900 Linear Feet 300
No Lines 4@75' Trench Width 36" Max Trench Bottom Depth 36" Gravel Depth

☐ New System ☐ Repair System Type: I, II, III, IV, V, VI
System Description: PUMP 25% REDUCTION
Repair System Description: LP LINE
Maintenance Agreement Required: ☐ Yes ☒ No

☒ House/Mod. Home No. Bedrooms 3
☐ Mobile Home No. Bathrooms 3
☐ Business No. Employees
☐ Other


☐ Slab ☒ Crawl Space ☐ Basement w/plumbing ☐ Basement wo/plumbing

Water Supply:
☒ Individual
☐ Public
☐ Community


Comments:/Conditions:

Comments:/Conditions:

INITIAL SITE SKETCH 1"=50'

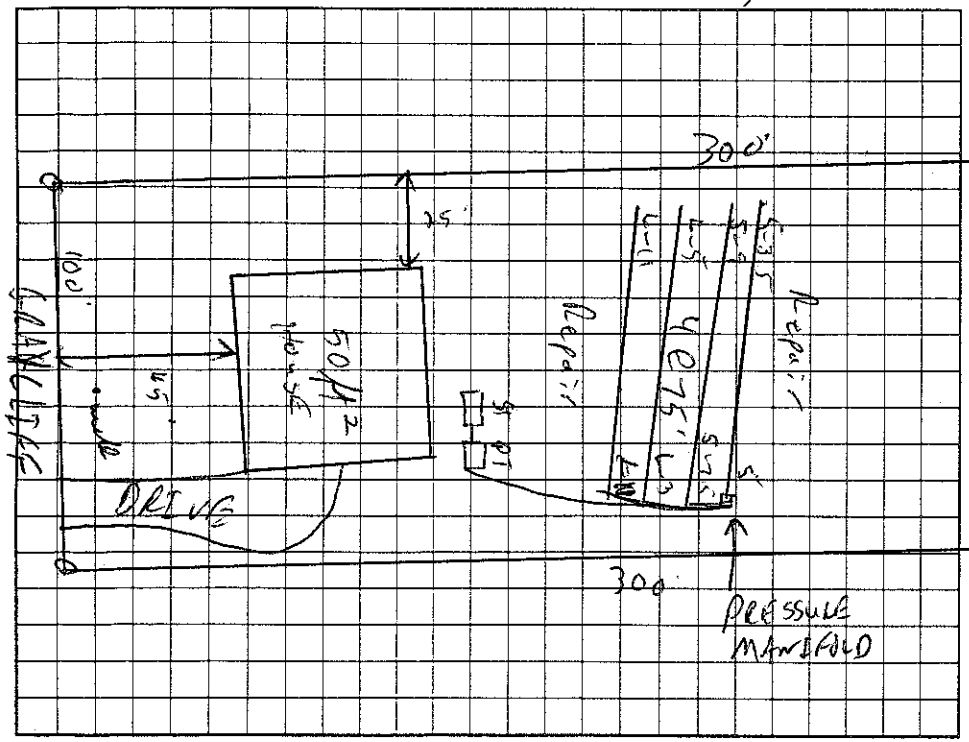

AS BUILT SKETCH

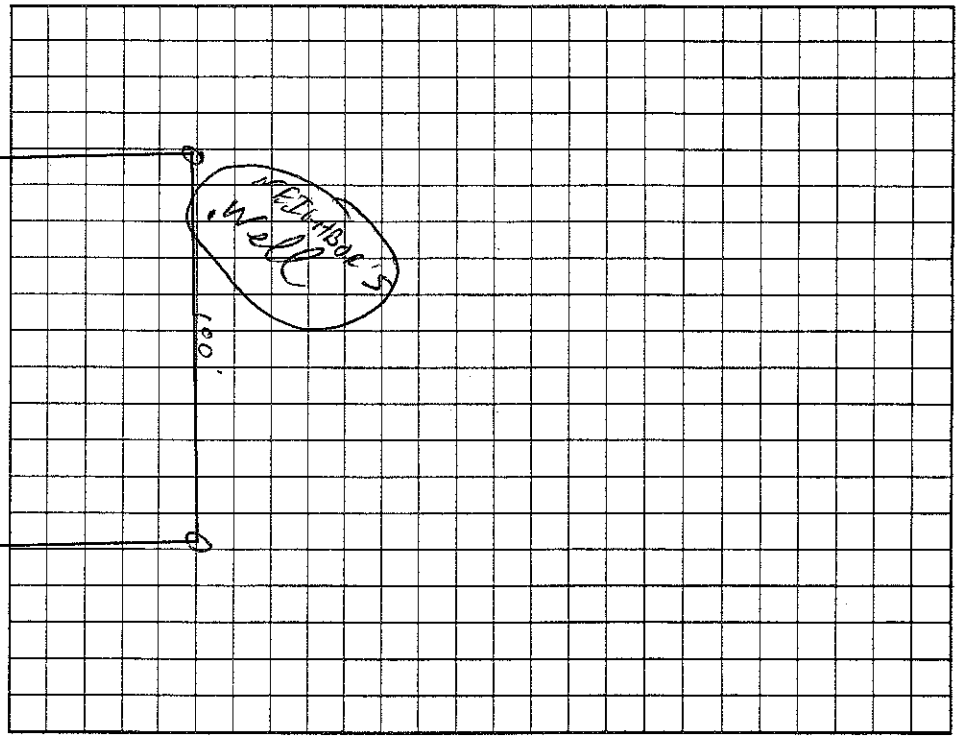

Permit can be suspended or revoked if any false information is supplied toward securing the permit/any unauthorized changes are made to the site/any unauthorized changes are made in the installation of the system. Improvement Permit with plat valid without expiration. Improvement Permit with site plan valid for sixty months. Authorization to Construct is valid for a period equal to that of Improvement Permit – not to exceed sixty months.

Signed: _____ date 8/31/03 Installed by: Wayne County

Improvement Permit by: _____ RS date 8/4/03 Operation Permit by: Wesley Sparks RS date 12/12/03

Authorization to Construct by: Wesley Sparks RS date 9/8/03 Existing System Inspection by: _____ date _____

HEALTH DEPT. COPY: WHITE OWNER COPY (FINAL): YELLOW OWNER COPY (INITIAL): PINK