IREDELL COUNTY HEALTH DEPARTMENT
IMPROVEMENT PERMIT / AUTHORIZATION TO CONSTRUCT / OPERATION PERMIT / EXISTING SYSTEM INSPECTION

STATESVILLE 704-878-5305 MOORESVILLE 704-664-5281

100.00 Paid

PERMIT# 11774

OWNER OR APPLICANT Lewis Carpenter PIN# 4639 96 2769 . 38 4649060431

ADDRESS PO Box 690027 Charlotte NC 28227 PHONE: Business 704-634-5183 Home

LOCATION Perth N TL 1st Honeysuckle Creek LP. DATE 10/17/05

SUBDIVISION Honeysuckle Creek BLOCK / SECTION LOT 38+38A LOT AREA 1.22 + .49A SITE CLASS. PS DESIGN FLOW 480 L.T.A.R. .25 (38A)

Septic Tank: 1000 Gallons; STB 312 Date 3/7/07

Pump Tank: 1000 Gallons; PT 11 Date 2/22/07

Pump Make: Pentair Model Level-Rite HS Serial No. C078505

Nitrification Field: No Fields Square Feet Shannon Linear Feet 480

No Lines 4@120' Trench Width 3' Max Trench Bottom Depth 3' Gravel Depth No

☒ New System ☐ Repair ☐ Expansion System Type: I II III IV V VI

System Description: PM - 250 Reduced

Repair System Description: LP - 16" PBPS

Maintenance Agreement Required: ☐ Yes ☒ No

☒ House/Mod. Home ☐ Mobile Home ☐ Business ☐ Other


No. Bedrooms 4 No. Persons 4 No. Employees

Water Supply: ☒ Individual ☐ Public ☐ Community

☐ Gravity ☒ Pressure ☐ Slab ☒ Crawl Space ☐ Basement w/plumbing ☐ Basement wo/plumbing


Comments:/Conditions:

INITIAL SITE SKETCH

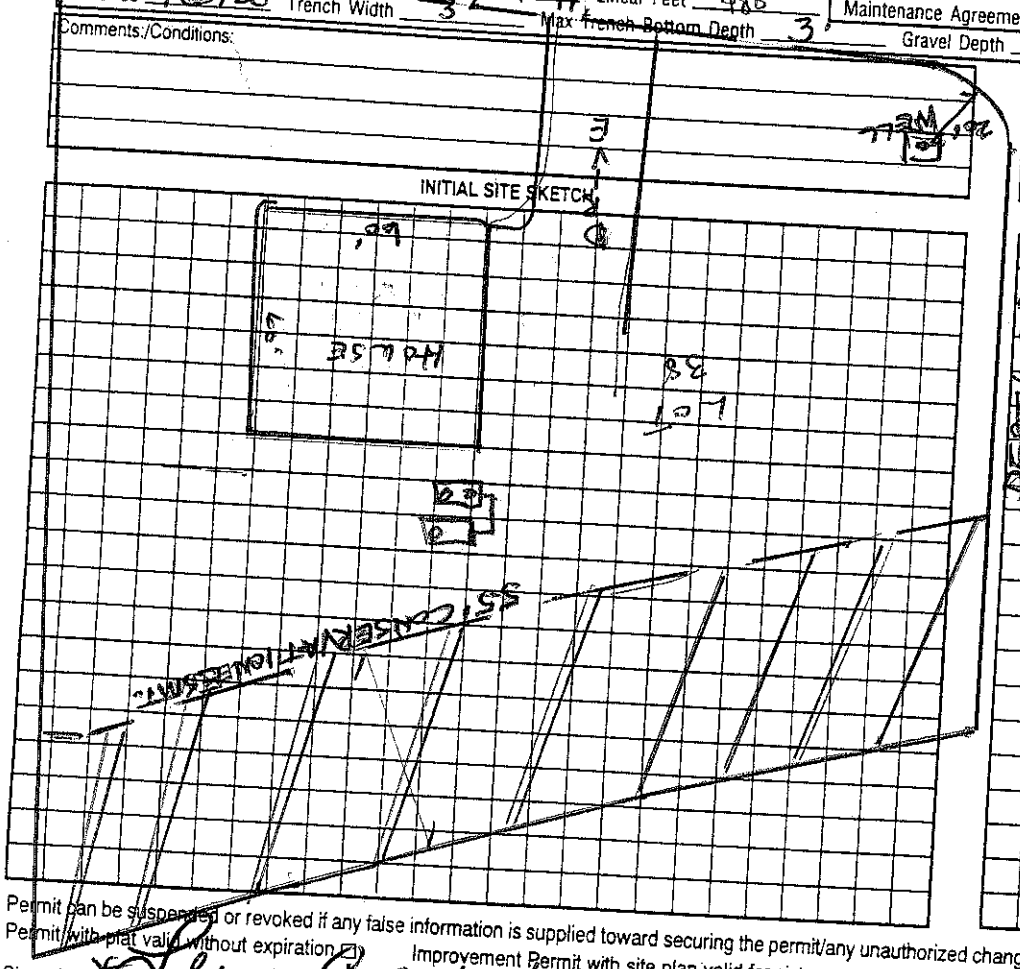

Comments:/Conditions:

AS BUILT SKETCH

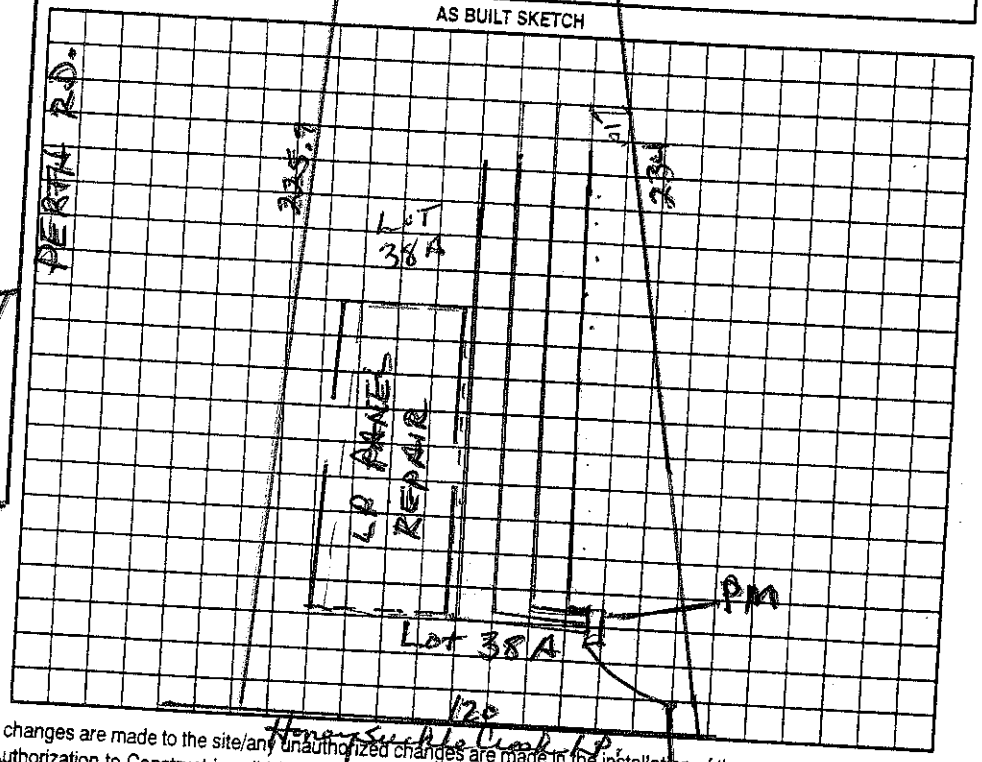

Permit can be suspended or revoked if any false information is supplied toward securing the permit/any unauthorized changes are made to the site/any unauthorized changes are made in the installation of the system. Improvement Permit with plat valid without expiration ☐ Improvement Permit with site plan valid for sixty months ☐ Authorization to Construct is valid for a period equal to that of Improvement Permit – not to exceed sixty months.

Signed: Lewis Carpenter date 2-10-06 Installed by: Larry Bracamonte

Improvement Permit by: Wesley Sparks RS. date 10/20/05 Operation Permit by: Wesley Sparks RS. date 8/24/07

Authorization to Construct by: Wesley Sparks RS date 10/20/05 Existing System Inspection by: date

HEALTH DEPT. COPY: WHITE OWNER COPY (FINAL): YELLOW OWNER COPY (INITIAL): PINK