IREDELL COUNTY HEALTH DEPARTMENT

STATESVILLE 704-878-5305 MOORESVILLE 704-664-5281

IMPROVEMENT PERMIT / AUTHORIZATION TO CONSTRUCT / OPERATION PERMIT / EXISTING SYSTEM INSPECTION

PERMIT# 117775 PIN# 4639962764.39 4649-06-0771 DATE 4/6/04

OWNER OR CONTRACTOR HONEYSUCKLE CREEK LLC / Pride Homes PHONE: Business 201-6465 Home

ADDRESS 227 HIDEAWAY LN MOORESVILLE NC 28117

LOCATION PERTH (N) - TL 1st HONEYSUCKLE - ON RT CORNER #261

SUBDIVISION HONEYSUCKLE CREEK BLOCK / SECTION LOT 39 LOT AREA .76 AC SITE CLASS. PS DESIGN FLOW 480GPD L.T.A.R. .256 PD/LF

Septic Tank: 1000 Gallons; STB 1019 Date 4/9/05
Pump Tank: 1000 Gallons; PT 17 Date 6/21/05
Pump Make: GOULDS Model WE0-511N Serial No. K05L69272
Nitrification Field: No Fields 1 Square Feet 1440 Linear Feet 480
No Lines 4@120' Trench Width 36" Max Trench Bottom Depth 36" Gravel Depth N/A

☒ New System ☐ Repair System Type: I, II, (III), IV, V, VI
System Description: PUMP 250G REDUCTION
Repair System Description: LP PANEL
Maintenance Agreement Required: ☐ Yes ☒ No

☒ House/Mod. Home No. Bedrooms 4
☐ Mobile Home No. Bathrooms 4
☐ Business No. Employees
☐ Other


☐ Slab ☒ Crawl Space ☐ Basement w/plumbing ☐ Basement wo/plumbing

Water Supply: ☒ Individual ☐ Public ☐ Community


Comments/Conditions:

Comments/Conditions:

1"=50' INITIAL SITE SKETCH

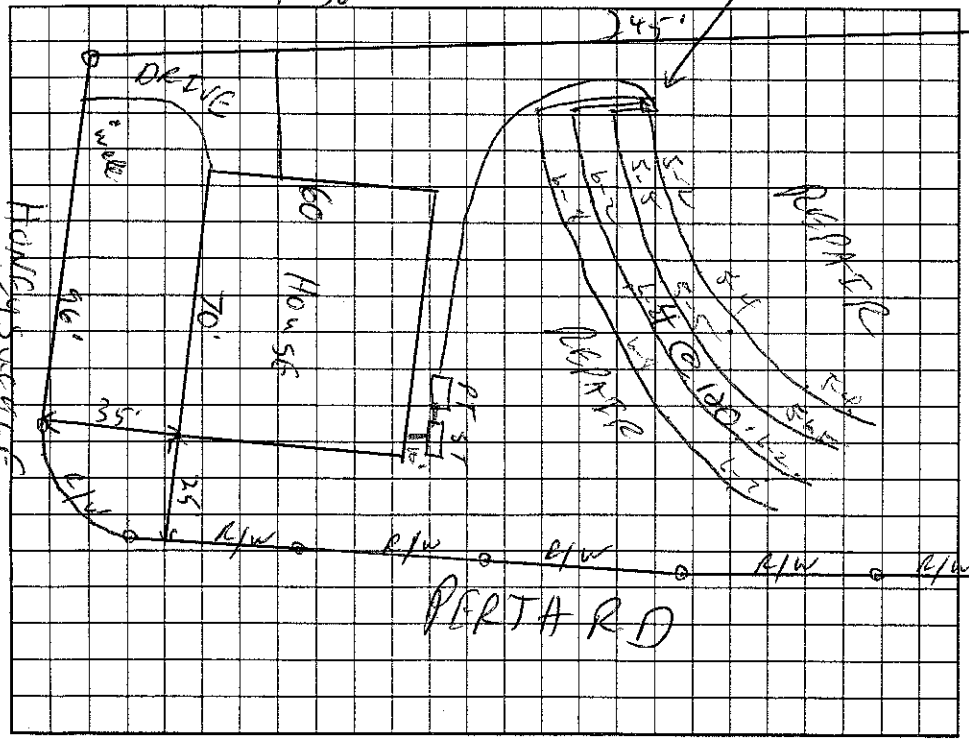

AS BUILT SKETCH

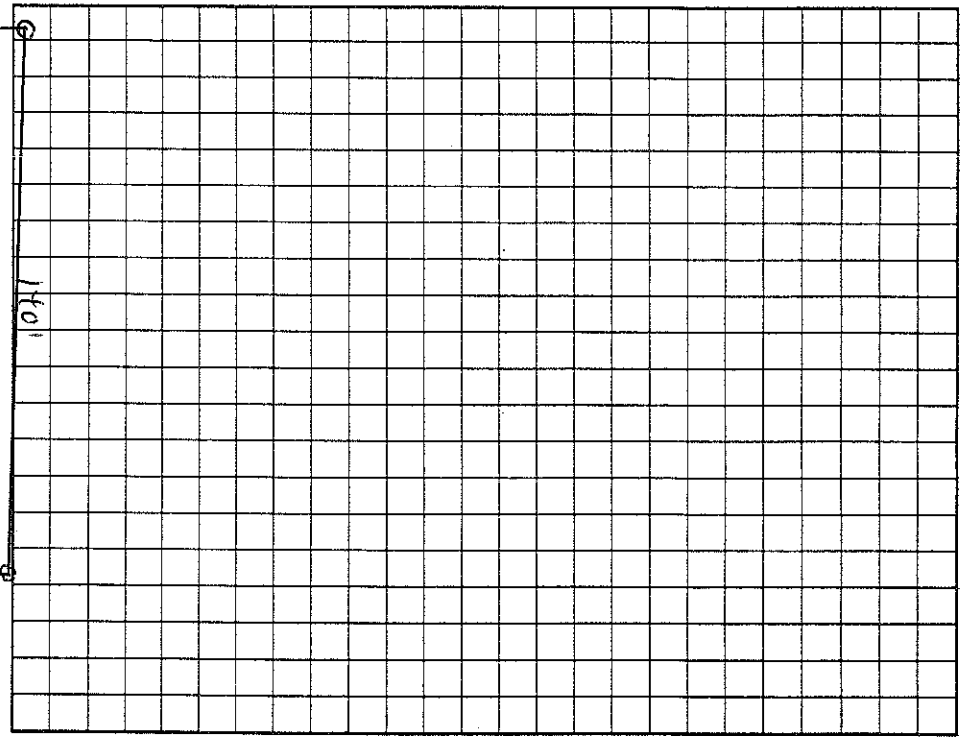

Permit can be suspended or revoked if any false information is supplied toward securing the permit/any unauthorized changes are made to the site/any unauthorized changes are made in the installation of the system. Improvement Permit with plat valid without expiration. Improvement Permit with site plan valid for sixty months. Authorization to Construct is valid for a period equal to that of Improvement Permit – not to exceed sixty months.

Signed: [signature] mrq date 7-28-04 Installed by: C+S

Improvement Permit by: [signature] RS date 4/6/04 Operation Permit by: [signature] RS date 11/22/05

Authorization to Construct by: [signature] RS date 6/15/05 Existing System Inspection by: date

HEALTH DEPT. COPY: WHITE OWNER COPY (FINAL): YELLOW OWNER COPY (INITIAL): PINK