IREDELL COUNTY HEALTH DEPARTMENT

STATESVILLE 704-878-5305 MOORESVILLE 704-664-5281

IMPROVEMENT PERMIT / AUTHORIZATION TO CONSTRUCT / OPERATION PERMIT / EXISTING SYSTEM INSPECTION

PERMIT# 116679 PIN# ~~4639-96-2767~~ 4649-06-0964 DATE 3/25/04

OWNER OR CONTRACTOR HONEYSUCKLE CREEK LLC (Haley Goodman) PHONE: Business 701-6465 Home

ADDRESS 227 HIDEAWAY LN MOORESVILLE NC 28117

LOCATION PERTH (N) - IL 2nd HONEYSUCKLE LOOP - ON LT CORNER

SUBDIVISION HONEYSUCKLE CK. BLOCK / SECTION LOT 1 LOT AREA ~~1.55~~ .54A SITE CLASS PS DESIGN FLOW 480GPD L.T.A.R. .2560 /FT²

Septic Tank: 1000 Gallons; STB 1012 Date 6/19/05

Pump Tank: Gallons; PT Date

Pump Make: Model Serial No.

Nitrification Field: No Fields 1 Square Feet 1440 Linear Feet 480

No Lines 4@120' Trench Width 36" Max Trench Bottom Depth 30"

☑ New System ☐ Repair System Type: I, II, III, IV, V, VI

System Description: GRAVITY 25% REDUCTION

Repair System Description: LP PANEL

Maintenance Agreement Required: ☐ Yes ☐ No

Gravel Depth N/A

☑ House/Mod. Home No. Bedrooms 4

☐ Mobile Home No. Bathrooms 4

☐ Business No. Employees

☐ Other


☐ Slab ☑ Crawl Space ☐ Basement w/plumbing ☐ Basement wo/plumbing

Water Supply: ☑ Individual ☐ Public ☐ Community


Comments:/Conditions: DO NOT CUT HOUSE PAD.

Comments:/Conditions:

INITIAL SITE SKETCH 1"=50'

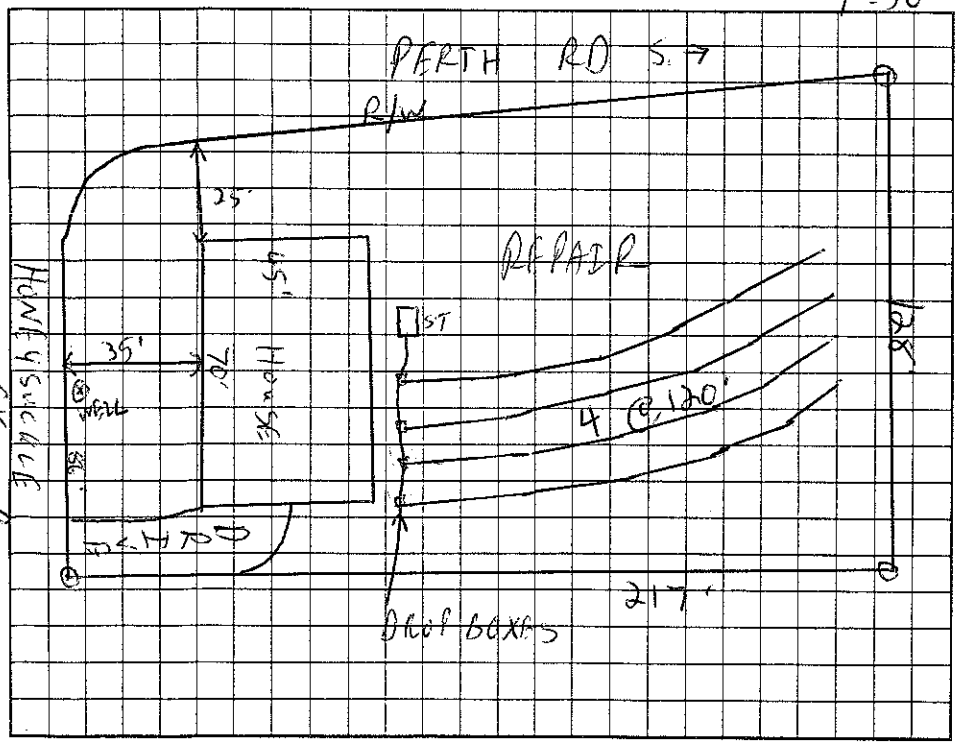

AS BUILT SKETCH

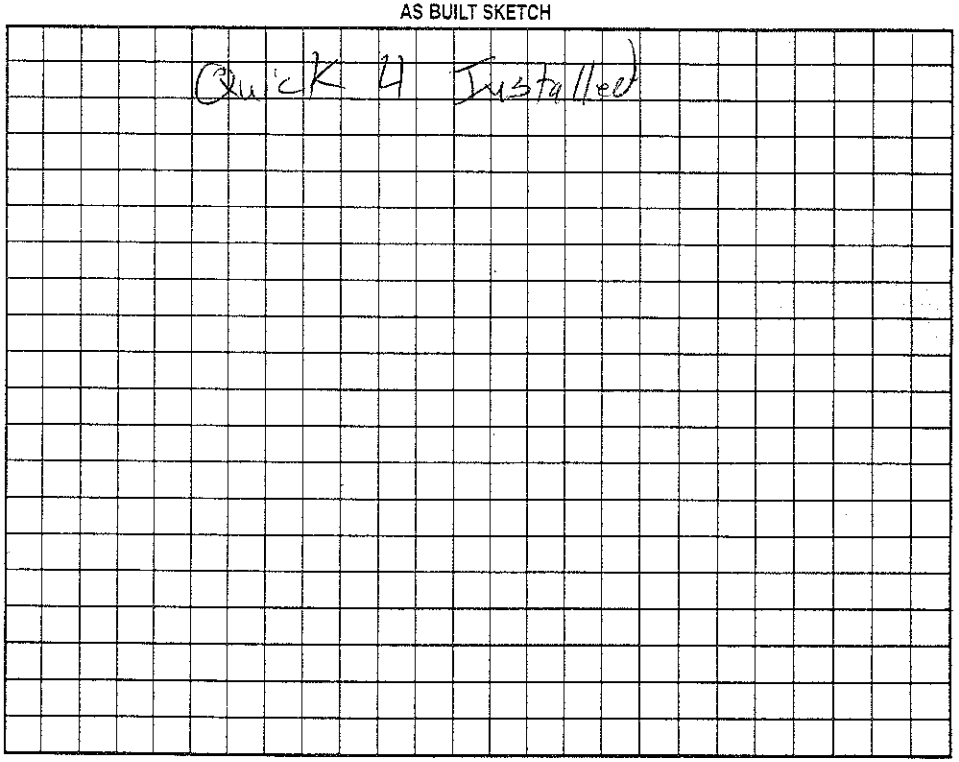

Permit can be suspended or revoked if any false information is supplied toward securing the permit/any unauthorized changes are made to the site/any unauthorized changes are made in the installation of the system. Improvement Permit with plat valid without expiration. Improvement Permit with site plan valid for sixty months. Authorization to Construct is valid for a period equal to that of Improvement Permit – not to exceed sixty months.

Signed: date 4-2-04 Installed by: C&S Grading

Improvement Permit by: RS date 3/25/04 Operation Permit by: RS date 2/14/06

Authorization to Construct by: RS date 10/10/05 Existing System Inspection by: date

HEALTH DEPT. COPY: WHITE OWNER COPY (FINAL): YELLOW OWNER COPY (INITIAL): PINK