S/D: GREYCLIFF

IREDELL COUNTY HEALTH DEPARTMENT

STATESVILLE 704-878-5305 375.00 Pd MOORESVILLE 704-664-5281

IMPROVEMENT PERMIT / AUTHORIZATION TO CONSTRUCT / OPERATION PERMIT / EXISTING SYSTEM INSPECTION

PERMIT# 126829 PIN# 464906 32 68 4649-06-4247 DATE 2/11/05

OWNER OR CONTRACTOR CORNERSTONE DEVELOPERS PHONE: Business Home

ADDRESS 19431 SCHOONER DR CORNELIUS 28031

LOCATION PERTH (N) - TR GREYCLIFF - 1ST ON LT

SUBDIVISION GREYCLIFF BLOCK / SECTION LOT 2&3 LOT AREA .859 SITE CLASS. PS DESIGN FLOW 360 L.T.A.R. .360/Ksa

Septic Tank: 1000 Gallons; STB 786 Date 2/3/05
Pump Tank: 1000 Gallons; PT 32 Date 3/8/05
Pump Make: ZOELLER Model W20-711 Serial No. 04
Nitrification Field: No Fields 1 Square Feet 420 Linear Feet 210
No Lines 3@70' Trench Width 24" Max Trench Bottom Depth 30" Gravel Depth N/A

☑ New System ☐ Repair System Type: I, II, III, IV, V, VI
System Description: CP PUMP
Repair System Description: SAME
Maintenance Agreement Required: ☑ Yes ☐ No

☑ House/Mod. Home No. Bedrooms 3
☐ Mobile Home No. Bathrooms 3
☐ Business No. Employees
☐ Other


☐ Slab ☑ Crawl Space ☑ Basement w/plumbing ☐ Basement wo/plumbing

Water Supply: ☑ Individual ☐ Public ☐ Community

Comments:/Conditions:

Comments:/Conditions:

INITIAL SITE SKETCH 1" = 100'

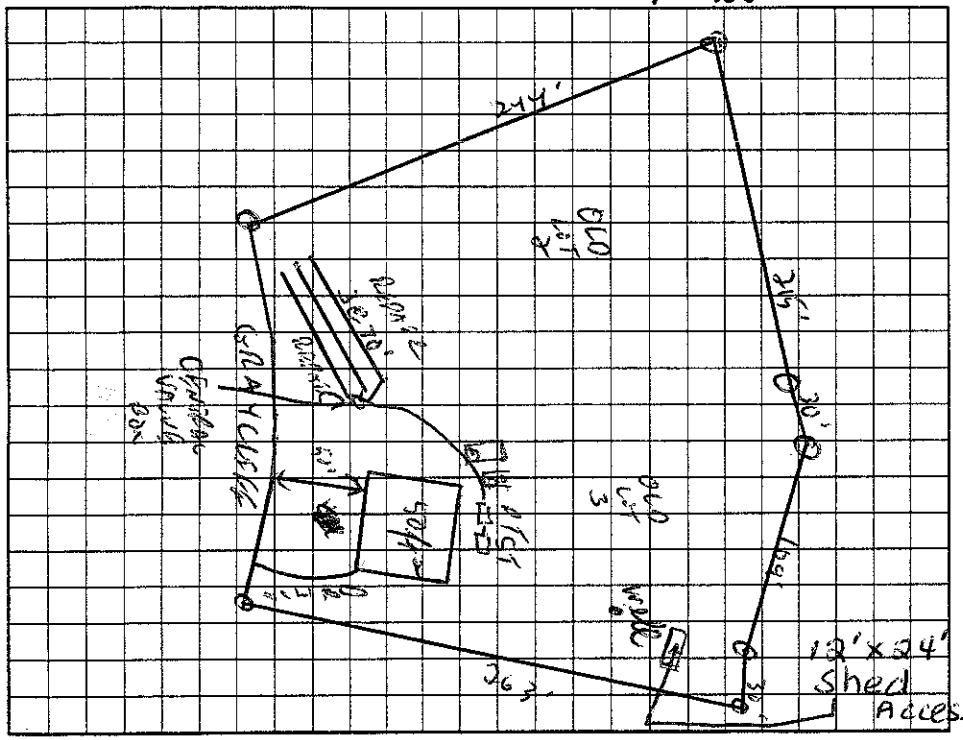

AS BUILT SKETCH

The location of the proposed Shed addition does not appear to impact the existing septic system.
**NOTE: must be at least 25' from well
Andy Melville REHS
Date: 11-2-10
ICHD-Environmental Health Division

Permit can be suspended or revoked if any false information is supplied toward securing the permit/any unauthorized changes are made to the site/any unauthorized changes are made in the installation of the system. Improvement Permit with plat valid without expiration. Improvement Permit with site plan valid for sixty months. Authorization to Construct is valid for a period equal to that of Improvement Permit – not to exceed sixty months.

Signed: date 2-14-05 Installed by: Cornerstone Development

Improvement Permit by: RS date 2/11/05 Operation Permit by: RS date 6/21/05

Authorization to Construct by: RS date 2/11/05 Existing System Inspection by: date

HEALTH DEPT. COPY: WHITE OWNER COPY (FINAL): YELLOW OWNER COPY (INITIAL): PINK