IREDELL COUNTY HEALTH DEPARTMENT

STATESVILLE 704-878-5305 MOORESVILLE 704-664-5281

IMPROVEMENT PERMIT / AUTHORIZATION TO CONSTRUCT / OPERATION PERMIT / EXISTING SYSTEM INSPECTION

PERMIT# 12844 PIN# 4649055641.04 4649-04-6213 DATE 10/8/03

OWNER OR CONTRACTOR CORINTHIAN BUILDERS/BURKE BUILDERS PHONE: Business 400-1055 Home

ADDRESS PO Box 990 DENVER NC 28037

LOCATION PERTH NORTH - JR GRAYCLIFF - ON LT

SUBDIVISION GRAYCLIFF BLOCK / SECTION LOT 4 LOT AREA SITE CLASS. PS DESIGN FLOW 360GPD L.T.A.R. .3660/FT²

Septic Tank: 1000 Gallons; STB 785 Date 11/04

Pump Tank: 1000 Gallons; PT 40 Date 11/04

Pump Make: MYERS Model ME100512 Serial No. 25320622

Nitrification Field: No Fields 1 Square Feet 420 Linear Feet 210

No Lines 6@35' Trench Width 24" Max Trench Bottom Depth 36" Gravel Depth N/A

☑ New System ☐ Repair System Type: I, II, (III), IV, V, VI

System Description: PUMP PANEL

Repair System Description: LP PANEL

Maintenance Agreement Required: ☐ Yes ☑ No

☑ House/Mod. Home ☐ Mobile Home ☐ Business ☐ Other

No. Bedrooms 3 No. Bathrooms 4 No. Employees


Water Supply: ☑ Individual ☐ Public ☐ Community

☐ Slab ☐ Crawl Space ☑ Basement w/plumbing ☐ Basement wo/plumbing


Comments:/Conditions: 4" SCH 40 x 2

Comments:/Conditions:

1"=50' INITIAL SITE SKETCH

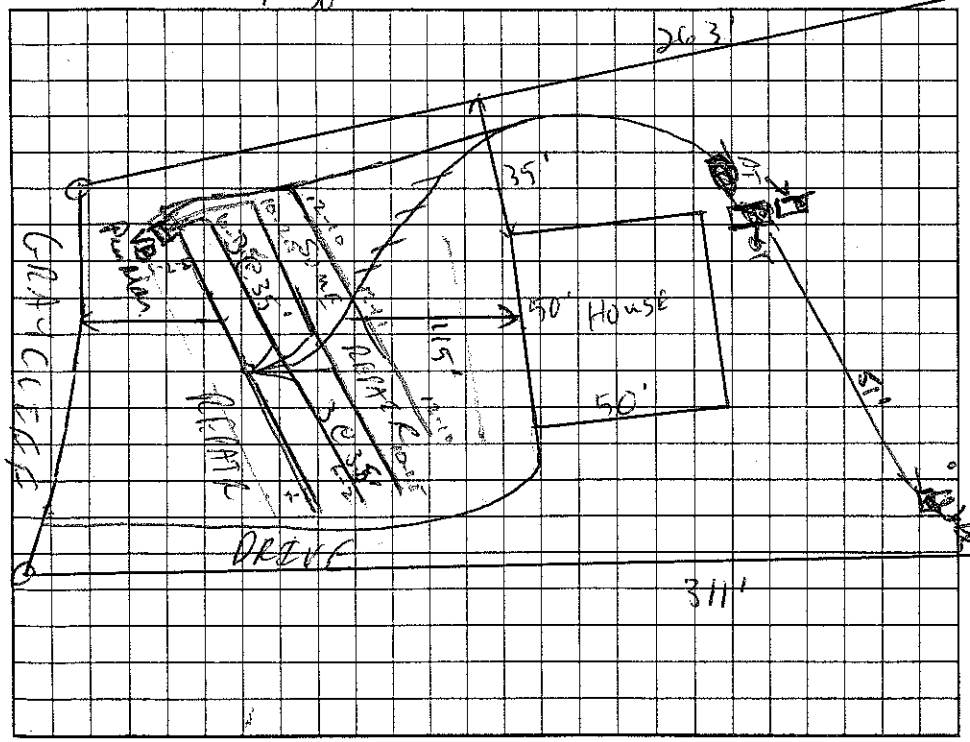

AS BUILT SKETCH

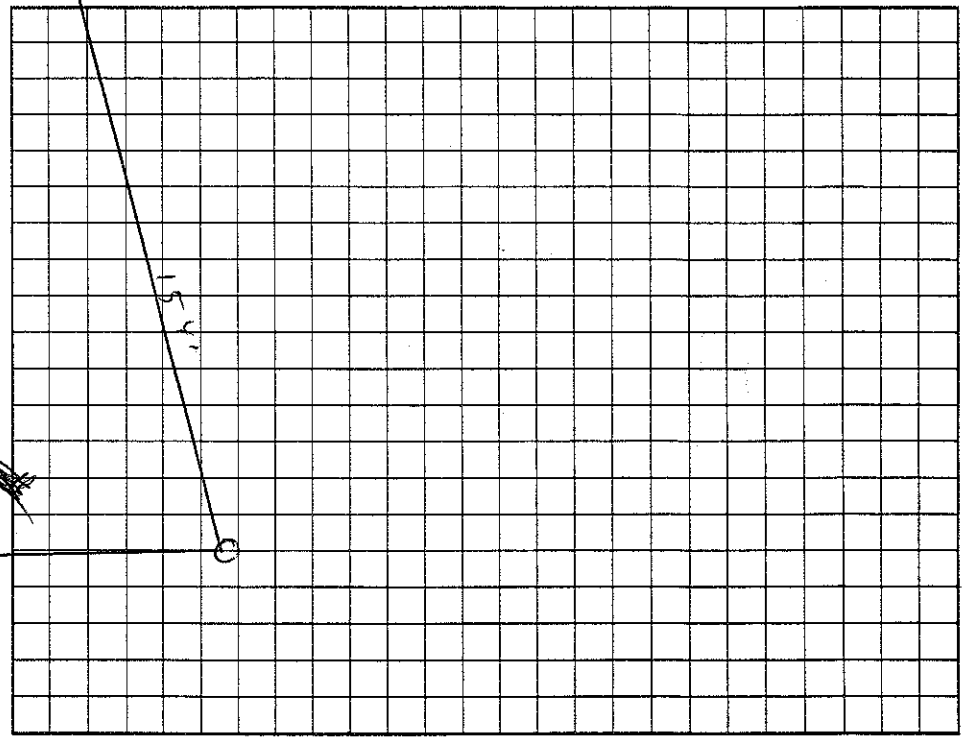

Permit can be suspended or revoked if any false information is supplied toward securing the permit/any unauthorized changes are made to the site/any unauthorized changes are made in the installation of the system. Improvement Permit with plat valid without expiration. Improvement Permit with site plan valid for sixty months. Authorization to Construct is valid for a period equal to that of Improvement Permit – not to exceed sixty months.

Signed: date Installed by:

Improvement Permit by: RS date 10/8/03 Operation Permit by: Wesley Sparks RS. date 6/22/04

Authorization to Construct by: RS date 10/15/03 Existing System Inspection by: date

HEALTH DEPT. COPY: WHITE OWNER COPY (FINAL): YELLOW OWNER COPY (INITIAL): PINK