IREDELL COUNTY HEALTH DEPARTMENT

STATESVILLE 704-878-5305 / 130.00 Paid MOORESVILLE 704-664-5281

IMPROVEMENT PERMIT / AUTHORIZATION TO CONSTRUCT / OPERATION PERMIT / EXISTING SYSTEM INSPECTION

PERMIT# 11846 PIN# ~~4649-05-5644.06~~ 4649-06-7091 DATE 2/11/04

OWNER OR CONTRACTOR CORINTHIAN DEVELOPMENT PHONE: Business 827-9697 Home

ADDRESS PO Box 990 DENVER NC 28037

LOCATION PERTH NORTH - TR GRAYCLIFF ON LT

SUBDIVISION GRAYCLIFF BLOCK / SECTION LOT 6 LOT AREA 1.39AC SITE CLASS PS DESIGN FLOW 450GPD L.T.A.R. .360/FT2

Septic Tank: 1000 Gallons: STB 785 Date 12/16/03
Pump Tank: Gallons: PT Date
Pump Make: Model Serial No.
Nitrification Field: No Fields 1 Square Feet 1440 Linear Feet 450
No Lines 6@80' Trench Width 36" Max Trench Bottom Depth 36" Gravel Depth N/A

☑ New System ☐ Repair System Type: I, II, (III), IV, V, VI
System Description: GRAVITY 25% REDUCTION
Repair System Description: PUMP 25% REDUCTION
Maintenance Agreement Required: ☐ Yes ☑ No


☑ House/Mod. Home No. Bedrooms 4
☐ Mobile Home No. Bathrooms 2
☐ Business No. Employees
☐ Other
☐ Slab ☑ Crawl Space ☐ Basement w/plumbing ☐ Basement wo/plumbing

Water Supply: ☑ Individual ☐ Public ☐ Community


Comments:/Conditions:

Comments:/Conditions: no filtration installed.

INITIAL SITE SKETCH 1"=50'

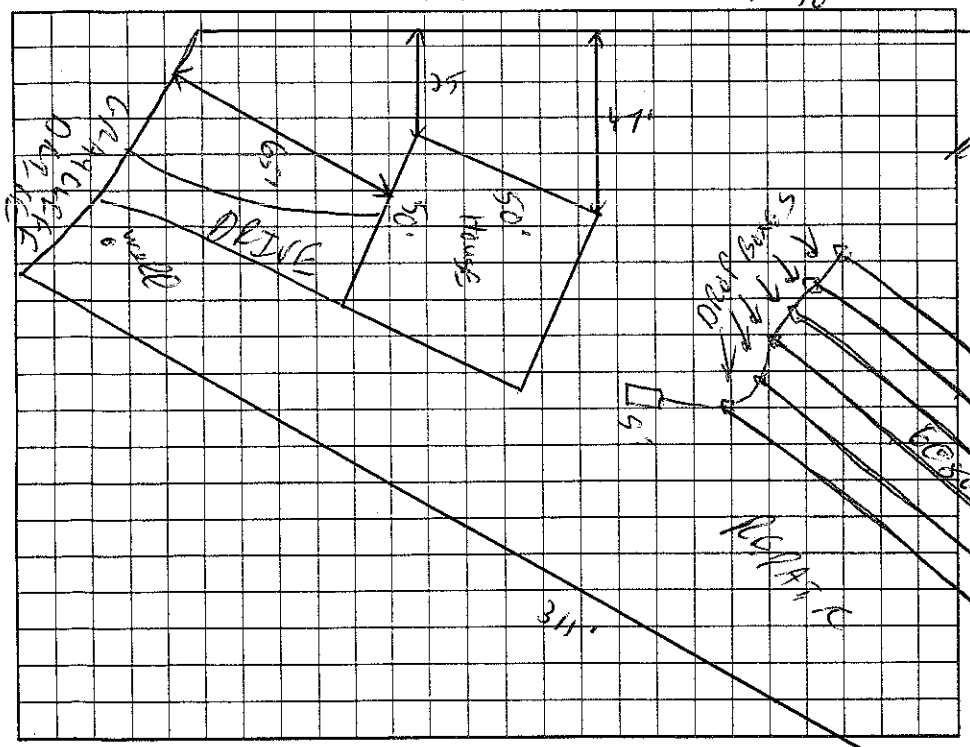

AS BUILT SKETCH

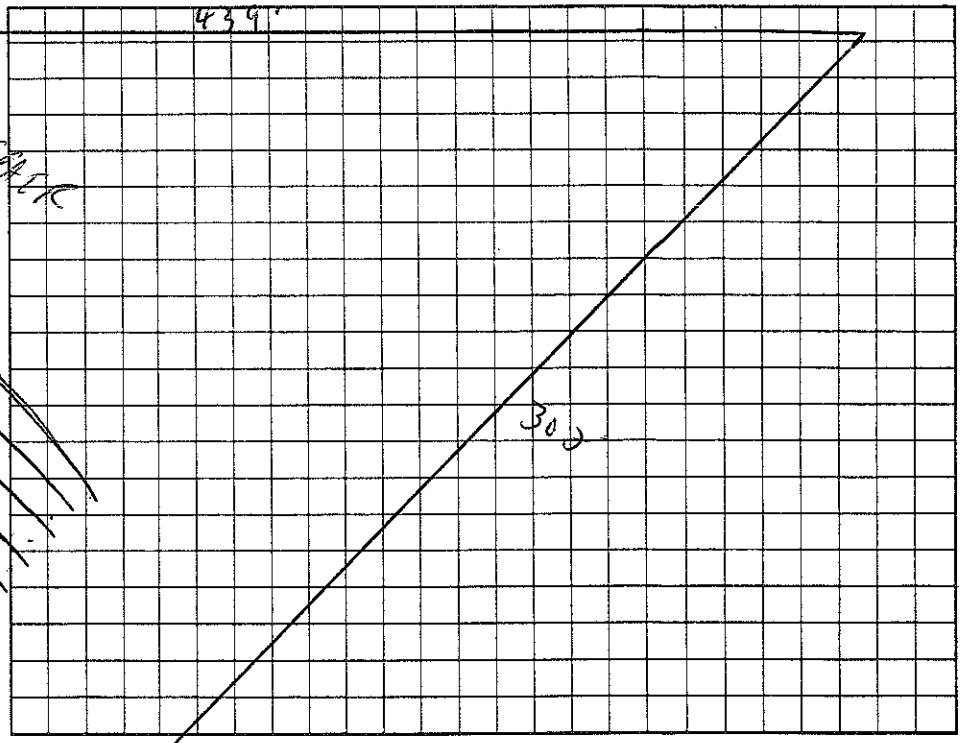

Permit can be suspended or revoked if any false information is supplied toward securing the permit/any unauthorized changes are made to the site/any unauthorized changes are made in the installation of the system. Improvement Permit with plat valid without expiration. Improvement Permit with site plan valid for sixty months. Authorization to Construct is valid for a period equal to that of Improvement Permit – not to exceed sixty months.

Signed: date

Improvement Permit by: C. [signature] RS date 2/11/04

Authorization to Construct by: C. [signature] RS date 2/11/04

Installed by: Corinthian Blders.

Operation Permit by: Wesley Sparks L.S. date 4/26/04

Existing System Inspection by: date

HEALTH DEPT. COPY: WHITE OWNER COPY (FINAL): YELLOW OWNER COPY (INITIAL): PINK