9:30

IREDELL COUNTY HEALTH DEPARTMENT

STATESVILLE 704-878-5305 MOORESVILLE 704-664-5281

IMPROVEMENT PERMIT / AUTHORIZATION TO CONSTRUCT / OPERATION PERMIT / EXISTING SYSTEM INSPECTION

PERMIT# Rep Air PIN# 4649069777 DATE 4-24-08

OWNER OR APPLICANT Jimmy Bottenfield PHONE: Business 704-472-9639 Home 704-732-2493

ADDRESS 147 Knoxview Ln Mooresville NC 28117

LOCATION 143 Knotty Pine Ln Mooresville NC 28117

SUBDIVISION S+S BLOCK / SECTION _____ LOT 11 LOT AREA _____ SITE CLASS. PS DESIGN FLOW 360* L.T.A.R. .3

Septic Tank: _____ Gallons: STB _____ Date _____

Pump Tank: _____ Gallons: PT _____ Date _____

Pump Make: _____ Model _____ Serial No. _____

Nitrification Field: No Fields 1 Square Feet 450' Linear Feet 150'

No Lines 3@50' Trench Width 36" Max Trench Bottom Depth 36"

☐ New System ☒ Repair ☐ Expansion System Type: I (II) III IV V VI

System Description: Gravity Conventional

Repair System Description: _____

Maintenance Agreement Required: ☐ Yes ☒ No

☐ House/Mod. Home ☒ Mobile Home ☐ Business ☐ Other _____

No. Bedrooms 3 No. Persons ____ No. Employees ____


Water Supply: ☒ Individual ☐ Public ☐ Community

Gravel Depth 12" ☒ Gravity ☐ Pressure ☐ Slab ☒ Crawl Space ☐ Basement w/plumbing ☐ Basement wo/plumbing

Comments/Conditions: Use existing tank / Use flow divider to equally divide effluent into 2 Distribution boxes / Each box will feed 4 lines / Use 9' on center for trenches

Comments/Conditions:

INITIAL SITE SKETCH

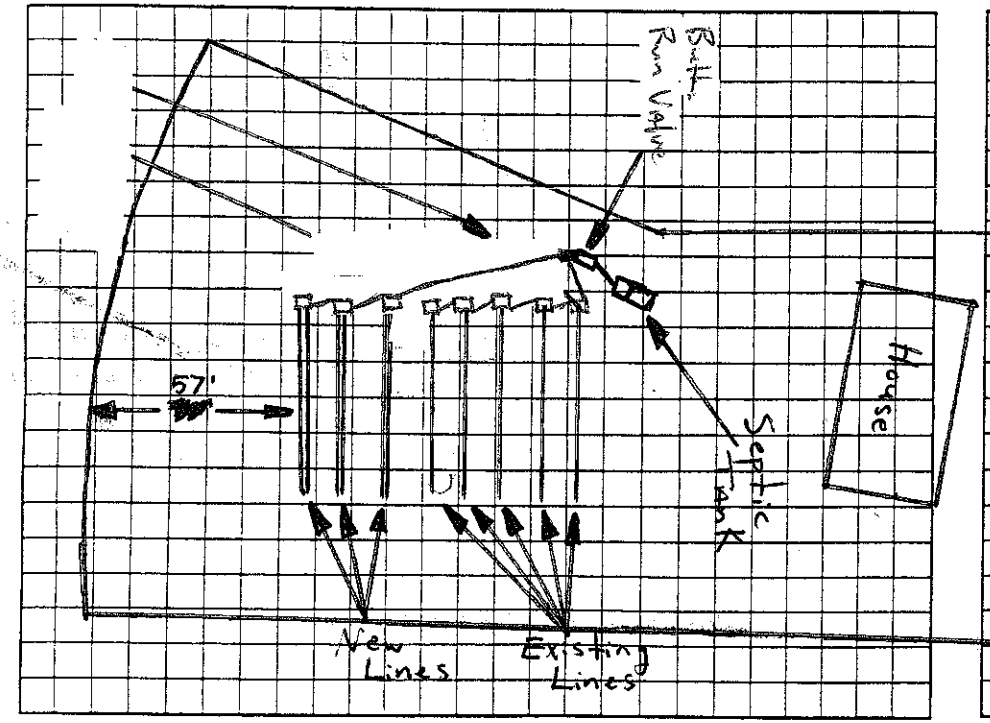

AS BUILT SKETCH

*Note - Could be distribution problem. If the distribution box is found to be off level then releveling could fix the problem. Speed levelers should be used in the distribution box. If it is a distribution problem the health department still needs to inspect before covering.

Permit can be suspended or revoked if any false information is supplied toward securing the permit/any unauthorized changes are made to the site/any unauthorized changes are made in the installation of the system. Improvement Permit with plat valid without expiration ☐ Improvement Permit with site plan valid for sixty months ☐ Authorization to Construct is valid for a period equal to that of Improvement Permit – not to exceed sixty months.

Signed: Jimmy Bottenfield date 4-25-08

Improvement Permit by: B-A-Allen date 4-24-08

Authorization to Construct by: B-A-Allen date 4-24-08

Installed by: _____

Operation Permit by: B-A-Allen date 6-12-08

Existing System Inspection by: _____ date _____

HEALTH DEPT. COPY: WHITE OWNER COPY (FINAL): YELLOW OWNER COPY (INITIAL): PINK