IREDELL COUNTY HEALTH DEPARTMENT

Authorization to Construct is valid for 60 months from date of (55 mo

STATESVILLE 704-878-5305 MOORESVILLE 704-664-5281

IMPROVEMENT PERMIT / ~~CERTIFICATE OF COMPLETION~~ / OPERATION PERMIT / EXISTING SYSTEM INSPECTION

PROPERTY DESCRIPTION NO. 23299 DATE 3/25/96 TAX MAP NO. 3F-D-A-4-6 pt of Watershed: ☑ Yes ☐ No

OWNER OR CONTRACTOR Deborah Bowers ~~PHONE: Business~~ 4649-07-5860 Home 892-8412

ADDRESS 152 Royal Pt Way Mooresville NC 28115

LOCATION Perth Rd from 150 - TL Fernhill 1/2 mile on Rt

SUBDIVISION R.F. Overcash RV BLOCK / SECTION ____ LOT 1 LOT AREA .79 ac SITE CLASS PS DESIGN FLOW 360 gpd L.T.A.R. .13 gpd/ft²

Septic Tank: 1000 Gallons; STB 825 Date 2-4-96

Pump Tank: ____ Gallons; PT ____ Date ____

Pump Make: ____ Model ____ Serial No. ____

Nitrification Field: No Fields 1 Square Feet 1200 Linear Feet 900

No Lines 4 Trench Width 36" Max Trench Bottom Depth 36" Gravel Depth 12"

☑ New System ☐ Repair System Type: I II III IV V VI

System Description: Gravity conventional

Repair System Description: Gravity Conventional

Maintenance Agreement Required: ☐ Yes ☐ No

☐ House/Mod. Home No. Bedrooms 3

☑ Mobile Home No. Bathrooms 2

☐ Business No. Employees ____

☐ Other ____


☐ Slab ☑ Crawl Space ☐ Basement w/plumbing ☐ Basement wo/plumbing

Water Supply: ☑ Individual ☐ Community ☐ Public


Comments:

Comments: Installed as drawn

INITIAL SITE SKETCH

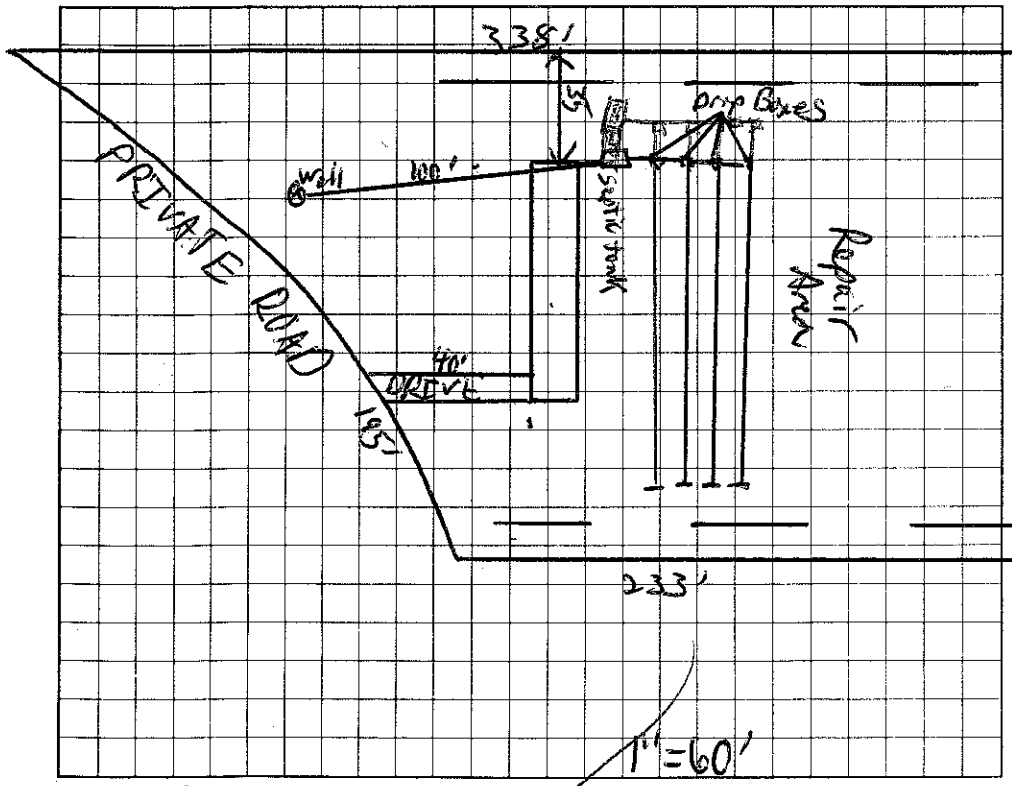

AS BUILT SKETCH

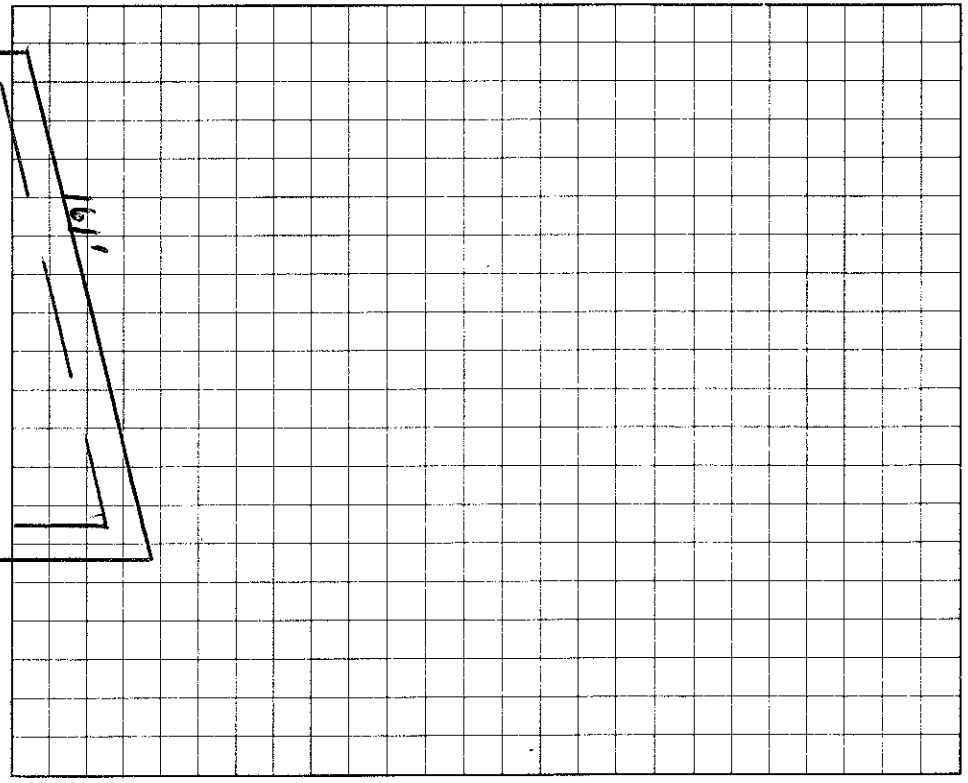

I understand that this permit can be suspended or revoked if any false information is supplied toward securing the permit/any unauthorized changes are made to the site/any unauthorized changes are made in the installation of the system.

Signed: Deborah Bowers

Installed by: Tim Bowers

Improvement Permit by: C. Bradshaw EHSI date 3/28/96

Existing System Inspection by: C. Bradshaw EHSI date 3/28/96

Certificate of Completion by: ____ date ____

Operation Permit by: Wesley Sparks R.S. date 4/19/96

HEALTH DEPT. COPY: WHITE INSPECTION COPY (FINAL): GREEN OWNER COPY (FINAL): YELLOW INSPECTION COPY (INITIAL): PINK OWNER COPY (INITIAL): GOLD