4649079275

IREDELL COUNTY HEALTH DEPARTMENT

↓ AUTHORIZATION TO CONSTRUCT

STATESVILLE 704-878-5305 MOORESVILLE 704-664-5281

IMPROVEMENT PERMIT / ~~CERTIFICATE OF COMPLETION~~ / OPERATION PERMIT / EXISTING SYSTEM INSPECTION

PROPERTY DESCRIPTION NO. 24845 DATE 9/18/96 TAX MAP NO. 3F-10-A-4 Watershed: ☑ Yes ☐ No

OWNER OR CONTRACTOR DEBRA BOWERS PHONE: Business _____ Home 376-5207

ADDRESS 152 ROYAL POINT WAY, MOORESVILLE 28115

LOCATION PERTH RD N - TR FERN HILL - TR DORCHESTER . 3rd LOT ON RT.

SUBDIVISION OVERCASH PROPERTY BLOCK / SECTION _____ LOT 4 LOT AREA .96 AC SITE CLASS. PS DESIGN FLOW 300 GPD L.T.A.R. .36 AC/FT +

Septic Tank: 1000 Gallons; STB 794 Date 9/26/96

Pump Tank: _____ Gallons; PT _____ Date _____

Pump Make: _____ Model _____ Serial No. _____

Nitrification Field: No Fields 1 Square Feet 1200 Linear Feet 400

No Lines 3 Trench Width 36" Max Trench Bottom Depth 36" Gravel Depth 12"

☑ New System ☐ Repair System Type: I (II) III, IV, V, VI

System Description: GRAVITY CONVENTIONAL

Repair System Description: PANEL

Maintenance Agreement Required: ☐ Yes ☑ No

☐ House/Mod. Home No. Bedrooms 3

☑ Mobile Home No. Bathrooms 2

☐ Business No. Employees _____

☐ Other _____


☐ Slab ☑ Crawl Space ☐ Basement w/plumbing ☐ Basement wo/plumbing

Water Supply: ☑ Individual ☐ Community ☐ Public

Comments: 511
61
61

Comments:

INITIAL SITE SKETCH 1" = 60'

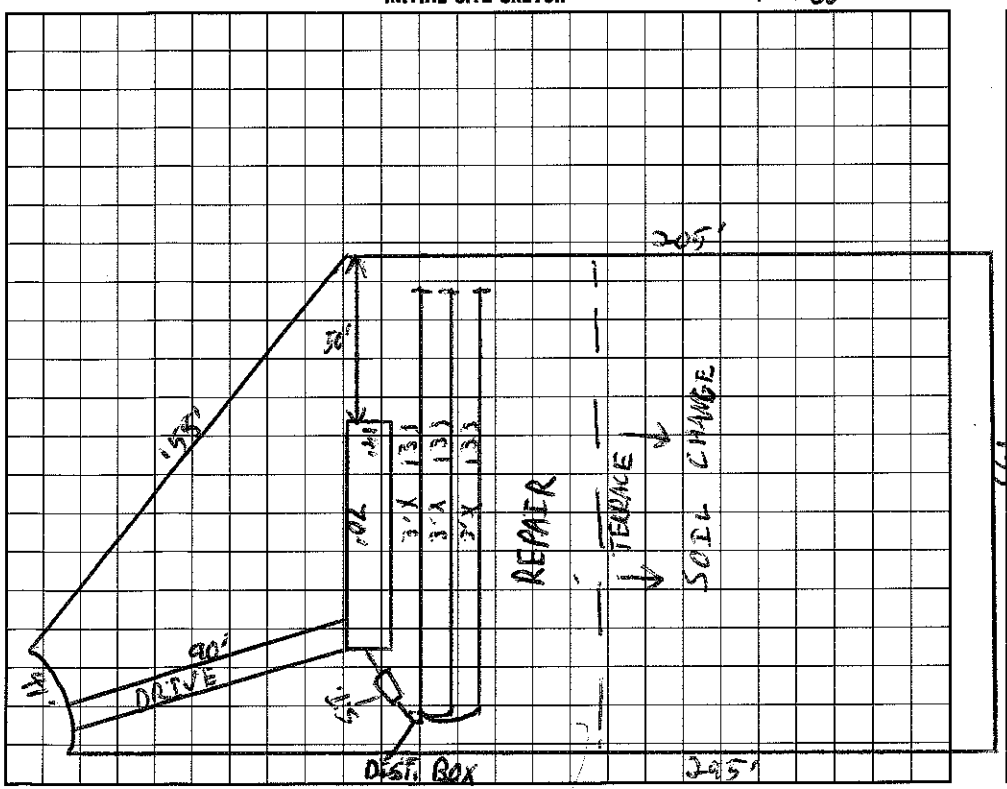

AS BUILT SKETCH

SAME AS SITE SKETCH

I understand that this permit can be suspended or revoked if any false information is supplied toward securing the permit/any unauthorized changes are made to the site/any unauthorized changes are made in the installation of the system.

Signed: Deborah Bowers

Installed by: TIM AMMONS

Improvement Permit by: C. Ruby Green EHSI date 9/18/96

Certificate of Completion by: _____ date _____

Existing System Inspection by: C. Ruby Green EHSI date 9/18/96

Operation Permit by: C. Ruby Green EHSI date 11/13/96

HEALTH DEPT. COPY: WHITE INSPECTION COPY (FINAL): GREEN OWNER COPY (FINAL): YELLOW INSPECTION COPY (INITIAL): PINK OWNER COPY (INITIAL): GOLD