Authorization to Construct

4649086158

IREDELL COUNTY HEALTH DEPARTMENT

STATESVILLE 704-878-5305 MOORESVILLE 704-664-5281

IMPROVEMENT PERMIT / ~~CERTIFICATE OF COMPLETION~~ / OPERATION PERMIT / EXISTING SYSTEM INSPECTION

PROPERTY DESCRIPTION NO. 24756 DATE 10/1/96 TAX MAP NO. 3F A 18 Watershed: X Yes ☐ No

OWNER OR CONTRACTOR Ernestine Johnson. PHONE: Business _____ Home 864-936-7266 WS IV CR

ADDRESS 11015 Beaties Ford Rd. Charlotte, NC.

LOCATION Fern Hill Rd., South Rd. TR Fern Hill Rd. on (L) just past Musgrove property

SUBDIVISION _____ BLOCK / SECTION _____ LOT _____ LOT AREA ~18.42 AC SITE CLASS. P3 DESIGN FLOW 240 L.T.A.R. .25

Septic Tank: 1000 Gallons; STB 926 Date 9/9/96
Pump Tank: _____ Gallons; PT _____ Date _____
Pump Make: _____ Model _____ Serial No. _____
Nitrification Field: No Fields 1 Square Feet 960 Linear Feet 330
No Lines 3 Trench Width 36" Max Trench Bottom Depth 30" Gravel Depth 12"

X New System ☐ Repair System Type: I (II) III, IV, V, VI
System Description: CONV - DIST BOX
Repair System Description: _____
Maintenance Agreement Required: ☐ Yes X No


☐ House/Mod. Home No. Bedrooms 2
X Mobile Home No. Bathrooms 1.5
☐ Business No. Employees _____
☐ Other _____
☐ Slab X Crawl Space ☐ Basement w/plumbing ☐ Basement wo/plumbing

Water Supply:
X Individual
☐ Community
☐ Public

Comments: _____

Comments: WELL NOT LOCATED AT Time OF INSPECTION

INITIAL SITE SKETCH

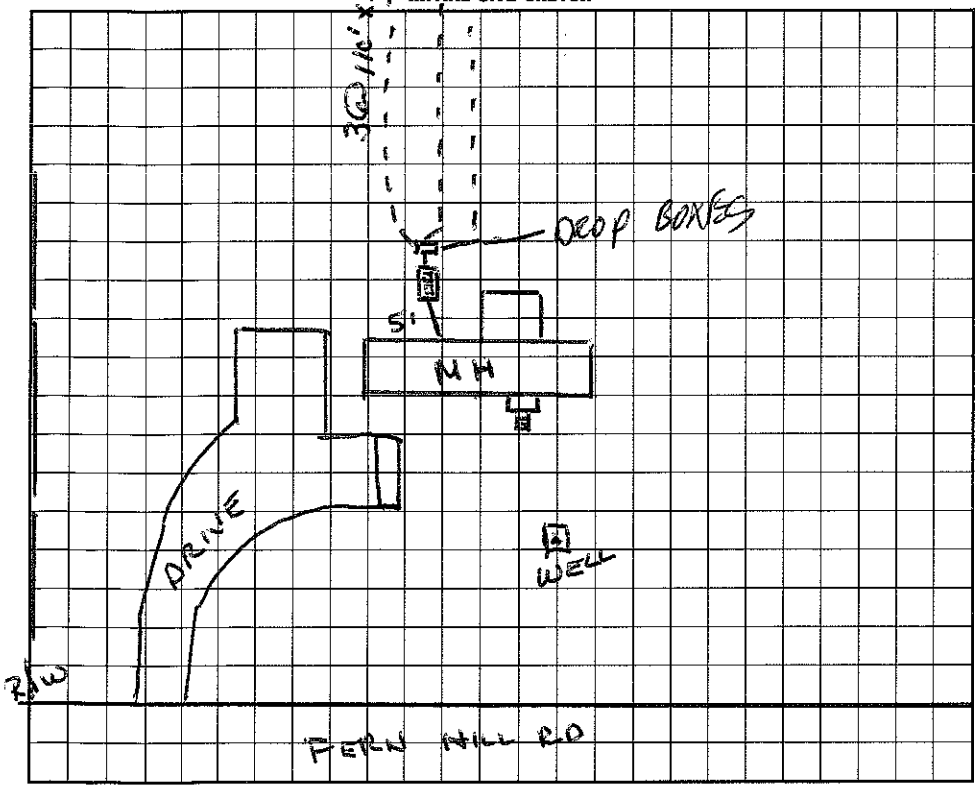

AS BUILT SKETCH

I understand that this permit can be suspended or revoked if any false information is supplied toward securing the permit/any unauthorized changes are made to the site/any unauthorized changes are made in the installation of the system.

Signed: X Ernestine Johnson

Improvement Permit by: Wesley Sparks R.S. date 10/1/96

Existing System Inspection by: Assistant Wesley Sparks R.S. date 10/1/96

Installed by: DENNIS WILLIS SEPTIC SERVICE

Certificate of Completion by: _____ date _____

Operation Permit by: C. Ray Treece EHSI date 10/14/96

HEALTH DEPT. COPY: WHITE INSPECTION COPY (FINAL): GREEN OWNER COPY (FINAL): YELLOW INSPECTION COPY (INITIAL): PINK OWNER COPY (INITIAL): GOLD