IREDELL COUNTY HEALTH DEPARTMENT

STATESVILLE 704-878-5305 MOORESVILLE 704-664-5281

IMPROVEMENT PERMIT / CERTIFICATE OF COMPLETION / OPERATION PERMIT / EXISTING SYSTEM INSPECTION

PROPERTY DESCRIPTION NO. 17308 DATE 3-10-94 TAX MAP NO. 25 A 51 Watershed: ☐ Yes ☐ No

OWNER OR CONTRACTOR KROM FINANCIAL SERVICES PHONE: Business 664-3671 Home

ADDRESS 19 Yacht Cove Mooresville NC 28115

LOCATION ~~north side of Cornelius road west of Judas road~~ 4649-10-2018

SUBDIVISION MILLS FPREST BLOCK / SECTION II LOT 26 LOT AREA 20,000min SITE CLASS. P DESIGN FLOW 360 L.T.A.R. 0.25

Septic Tank: 1000 Gallons; STB 825 Date 7/1/94

Pump Tank: 1000 Gallons; PT 477 Date 10/1/94

Pump Make: Model Serial No.

Nitrification Field: No Fields 1 Square Feet 1440 Linear Feet 480

No Lines 4 Trench Width 36" Max Trench Bottom Depth 22" Gravel Depth 12"

☒ New System ☐ Repair System Type: I, (II) III, IV, V, VI

System Description: pump conventional

Repair System Description: pump conventional

Maintenance Agreement Required: ☐ Yes ☒ No

☒ House/Mod. Home No. Bedrooms 3

☐ Mobile Home No. Bathrooms 2

☐ Business No. Employees

☐ Other

☐ Slab ☒ Crawl Space ☐ Basement w/plumbing ☐ Basement wo/plumbing

Water Supply: ☒ Individual ☐ Community ☐ Public


Comments: Do not install during wet soil conditions or rain.
Pressure manifold with 2" Pressure - 1½" threaded
through manifold to 3/4" PVC into conventional
trenches

DEVELOPER 2/2/95 AWS

Comments:

ISSUED

INITIAL SITE SKETCH

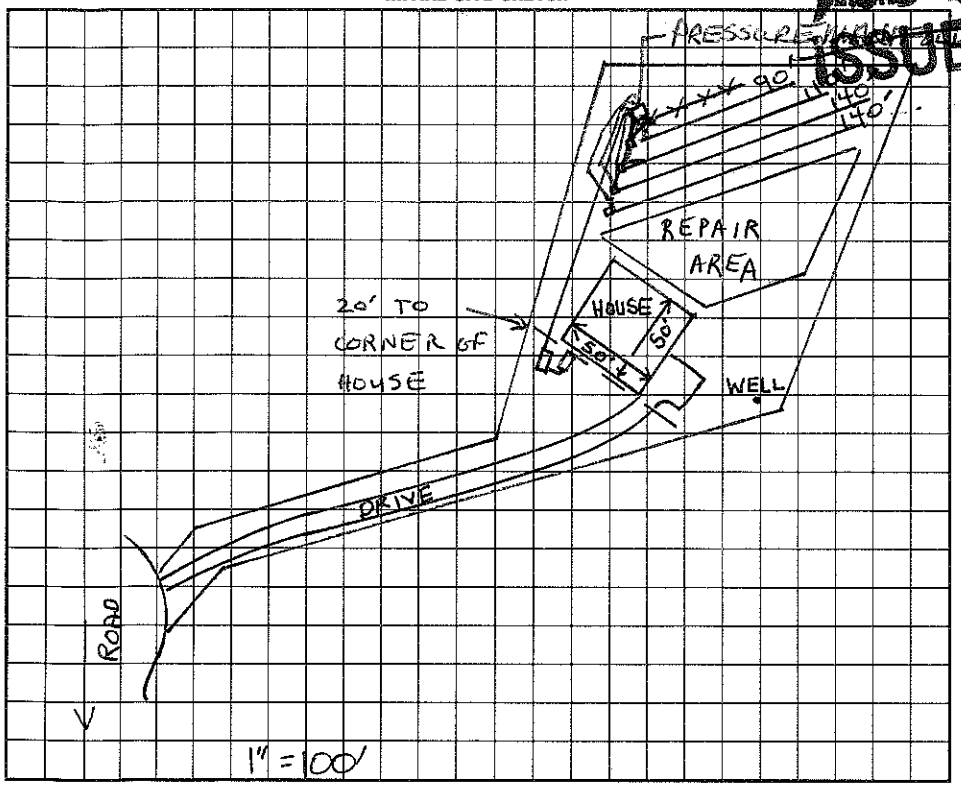

AS BUILT SKETCH

I understand that this permit can be suspended or revoked if any false information is supplied toward securing the permit/any unauthorized changes are made to the site/any unauthorized changes are made in the installation of the system. Improvement Permit is valid for 60 months from date of issuance.

Signed:

Improvement Permit by: Andrea Lemon date 3-11-94

Existing System Inspection by: date

Installed by:

Certificate of Completion by: date

Operation Permit by: RS date 2-7-95

HEALTH DEPT. COPY: WHITE INSPECTION COPY (FINAL): GREEN OWNER COPY (FINAL): YELLOW INSPECTION COPY (INITIAL): PINK OWNER COPY (INITIAL): GOLD