IREDELL COUNTY HEALTH DEPARTMENT

Authorization to Construct 4649151719

STATESVILLE 704-878-5305 MOORESVILLE 704-664-5281

IMPROVEMENT PERMIT / ~~CERTIFICATE OF COMPLETION~~ / OPERATION PERMIT / EXISTING SYSTEM INSPECTION

PROPERTY DESCRIPTION NO. 067836 DATE 8/19/97 TAX MAP NO. 4649152943 Watershed: X Yes ☐ No

OWNER OR CONTRACTOR Richard Dlugokecki PHONE: Business _____ Home 663-5722

ADDRESS 116 Raydecki Drive Mooresville, NC. 28115

LOCATION Perth Rd. TR Knotty Pine Ln. top of hill TR on gravel (R) 1st drive on (R)

SUBDIVISION S+S Properties BLOCK / SECTION _____ LOT _____ LOT AREA ~6 Ac SITE CLASS. PS DESIGN FLOW 480 L.T.A.R. 3

Septic Tank: 1000 Gallons; STB 1009 Date 11/2/97

Pump Tank: _____ Gallons; PT _____ Date _____

Pump Make: _____ Model _____ Serial No. _____

Nitrification Field: No Fields 1 Square Feet 1600 Linear Feet 533

No Lines 4 Trench Width 36" Max Trench Bottom Depth 36" Gravel Depth 12"

X New System ☐ Repair System Type: I, (II), III, IV, V, VI

System Description: Gravity Conventional

Repair System Description: _____

Maintenance Agreement Required: ☐ Yes X No

X House/Mod. Home ☐ Mobile Home ☐ Business ☐ Other

No. Bedrooms 4 No. Bathrooms 3 No. Employees _____


☐ Slab X Crawl Space ☐ Basement w/plumbing ☐ Basement wo/plumbing

Water Supply: X Individual ☐ Community ☐ Public


Comments:

Comments: INSTALLED AS DRAWN ON AUTH. TO CONSTRUCT

INITIAL SITE SKETCH

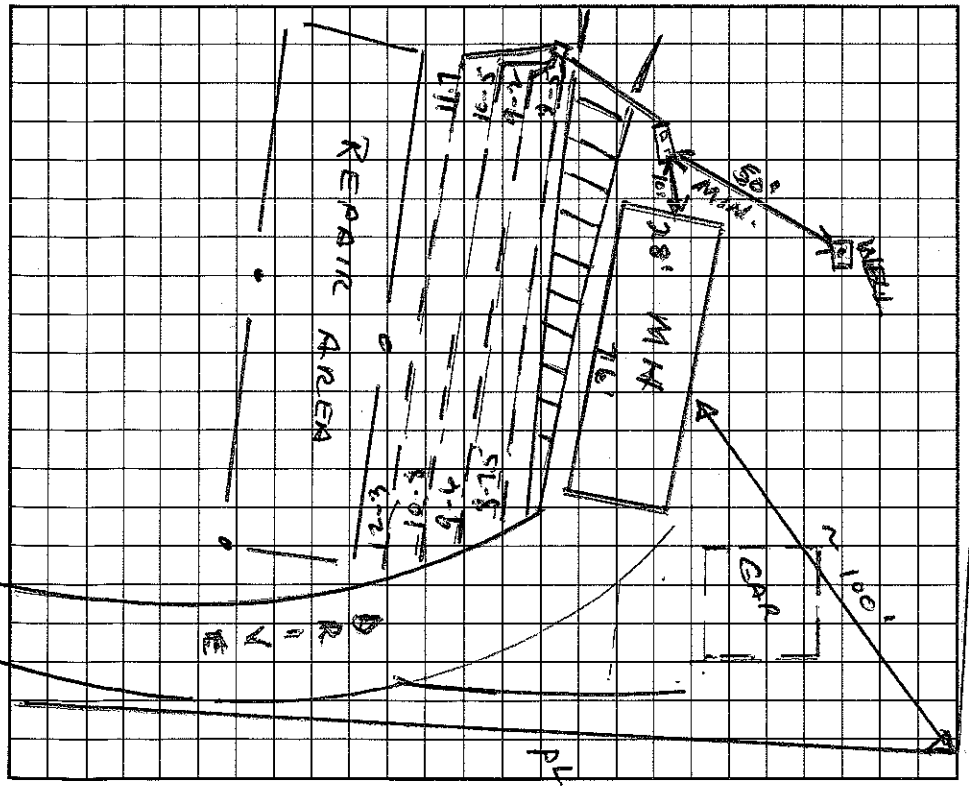

AS BUILT SKETCH

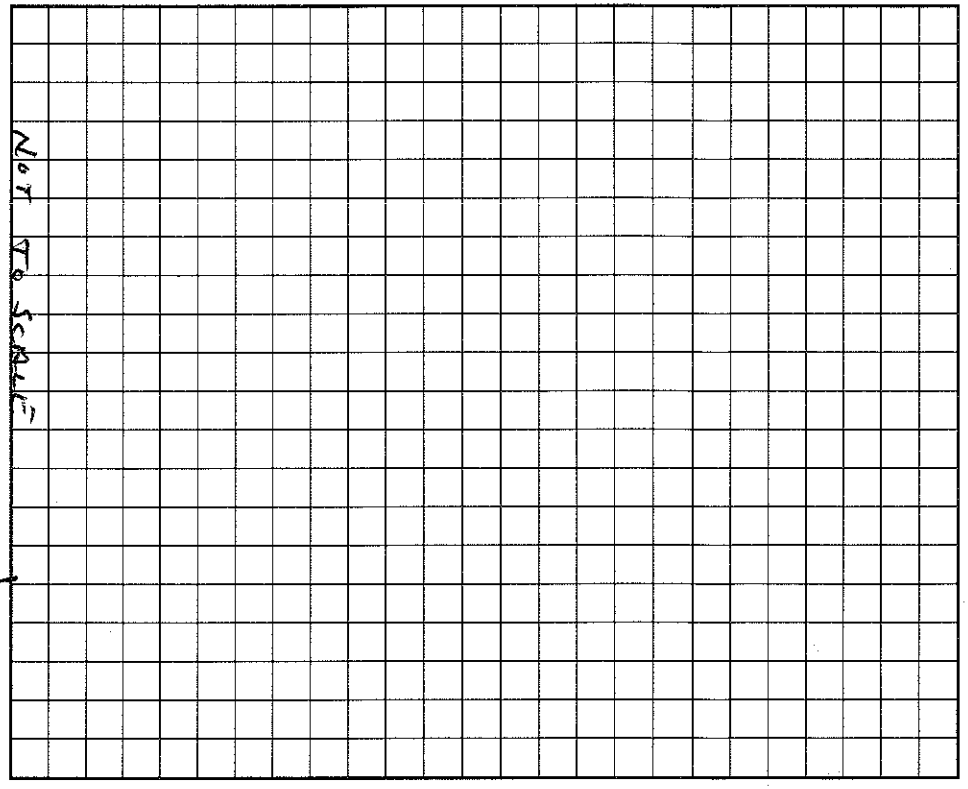

I understand that this permit can be suspended or revoked if any false information is supplied toward securing the permit/any unauthorized changes are made to the site/any unauthorized changes are made in the installation of the system. Improvement Permit is valid for 60 months from date of issuance.

Signed: X Jeanetta L. Dlugokecki

Installed by: ~~Jimmy Kinder~~ JIMMY KINDER

Improvement Permit by: Wesley Sparks R.S. date 8/19/97

Certificate of Completion by: Wesley Sparks R.S. date 12/18/97

Existing System Inspection by: Wesley Sparks R.S. date 8/19/97

Operation Permit by: Wesley Sparks R.S. date 12/18/97

HEALTH DEPT. COPY: WHITE INSPECTION COPY (FINAL): GREEN OWNER COPY (FINAL): YELLOW INSPECTION COPY (INITIAL): PINK OWNER COPY (INITIAL): GOLD