Site Address: 151 Orchard Farm Ln, Mrsvl.

IREDELL COUNTY HEALTH DEPARTMENT

STATESVILLE 704-878-5305 MOORESVILLE 704-664-5281

IMPROVEMENT PERMIT / AUTHORIZATION TO CONSTRUCT / OPERATION PERMIT / EXISTING SYSTEM INSPECTION

PERMIT# ~~13503~~ 20756O PIN# ~~4641049444.000~~ 4649.15.2450 DATE October 17, 2006

OWNER OR APPLICANT ~~Orchard Farms LLC~~ LAKESHORE HOLDINGS PHONE: Business _____ Home _____

ADDRESS 227 Hideaway Lane, Mooresville, N.C. 28117 295 Lake Mist Dr.

LOCATION Neal Rd. @ 10 past Judas Rd. TR Wild Cherry Lane TL Orchard Farm Lane at end

SUBDIVISION The Orchard BLOCK / SECTION _____ LOT 11 LOT AREA ± 28,436 ft² SITE CLASS. RS DESIGN FLOW 480 gpd L.T.A.R. ±3

Septic Tank: 1000 Gallons; STB 760 Date 11-18

Pump Tank: _____ Gallons; PT _____ Date _____

Pump Make: _____ Model _____ Serial No. _____

Nitrification Field: No Fields 1 Square Feet 1200 Linear Feet 400

No Lines 3 Trench Width 36" Max Trench Bottom Depth 36"

☒ New System ☐ Repair ☐ Expansion System Type: I II III IV V VI

System Description: Gravity 25% Reduction Accepted" LP PUMPS

Repair System Description: _____

Maintenance Agreement Required: ☐ Yes ☒ No

☒ House/Mod. Home ☐ Mobile Home ☐ Business ☐ Other

No. Bedrooms 4 No. Persons _____ No. Employees _____

Water Supply: ☒ Individual ☐ Public ☐ Community

Gravel Depth N/A ☒ Gravity ☐ Pressure ☐ Slab ☐ Crawl Space ☒ Basement w/plumbing ☐ Basement wo/plumbing


Comments:/Conditions:

Comments:/Conditions:

INITIAL SITE SKETCH

SEE PLAN from Rollins Soil & Env. Services

AS BUILT SKETCH

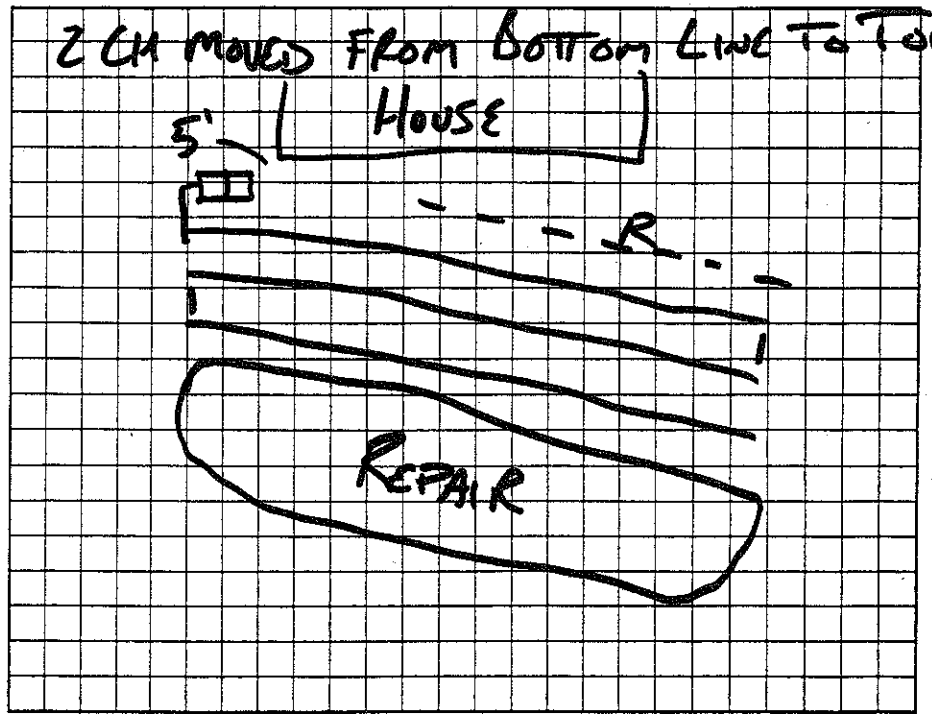

Permit can be suspended or revoked if any false information is supplied toward securing the permit/any unauthorized changes are made to the site/any unauthorized changes are made in the installation of the system. Improvement Permit with plat valid without expiration ☐ Improvement Permit with site plan valid for sixty months ☒ Authorization to Construct is valid for a period equal to that of Improvement Permit – not to exceed sixty months.


Signed: _____ date 10-26-06 Installed by: CHUB

Improvement Permit by: _____ date 10-17-06 Operation Permit by: _____ date 41075

Authorization to Construct by: _____ date _____ Existing System Inspection by: _____ date _____

APPROVED DEC 12 2014

HEALTH DEPT. COPY: WHITE OWNER COPY (FINAL): YELLOW OWNER COPY (INITIAL): PINK

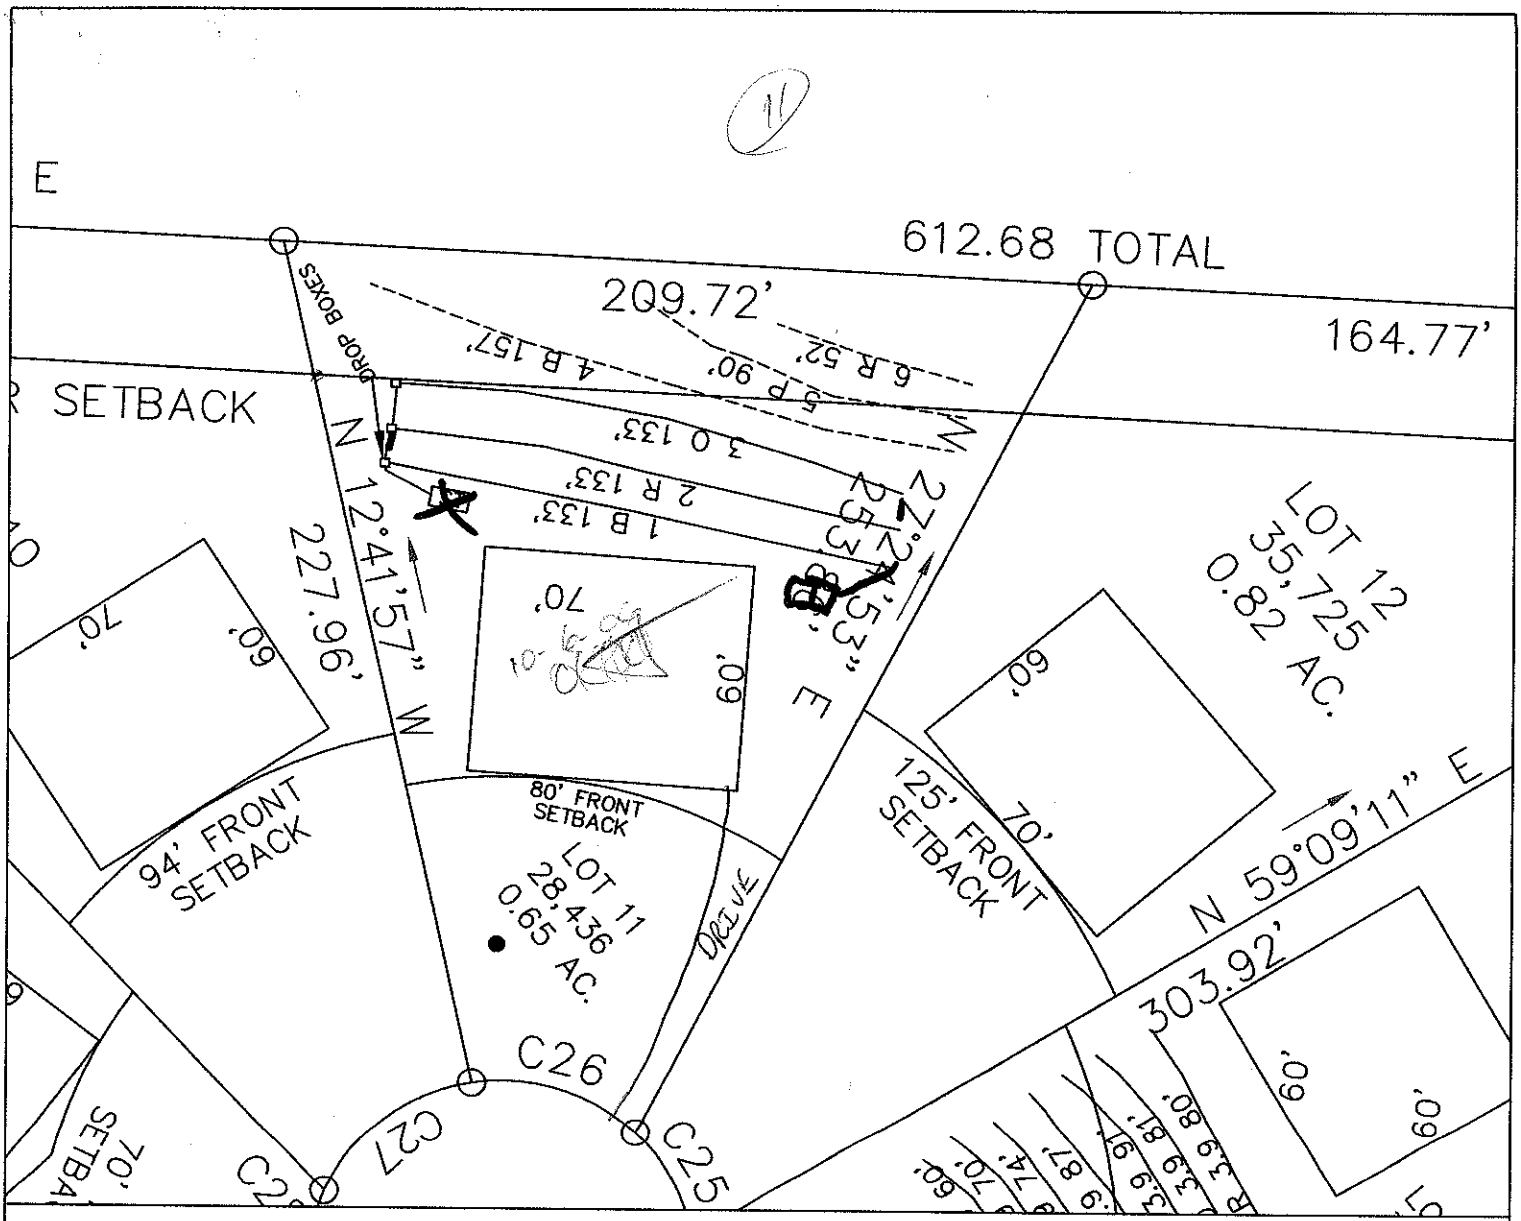

FOR PRELIMINARY PLANNING PURPOSES ONLY. ALL LOTS WILL REQUIRE FINAL APPROVAL BY THE COUNTY HEALTH DEPARTMENT ON A LOT BY LOT BASIS. THIS MAP SHOULD BY USED AS A GENERAL GUIDE, SOME ADJUSTMENTS WILL BE NECESSARY IN THE FIELD DUE TO SOIL VARIABILITY AND COMPLEX TOPOGRAPHIC FEATURES. THIS MAP ONLY REFLECTS EXISTING SOIL SUITABILITY FOR ON-SITE SEPTIC TANK SYSTEMS.

PLEASE REFER TO ATTACHED SOIL REPORT FOR ADDITIONAL SITE SPECIFIC INFORMATION

ROLLANS SOIL & ENVIRONMENTAL SERVICES
2120 GRAHAM ROAD
MOUNT ULLA, NC 28125
PHONE/FAX: (704) 278 - 0989
ASHLEY ROLLANS, NC LICENSED SOIL SCIENTIST
MOBILE: (704) 746 - 5046
EMAIL: ROLLANSFORTC)@AOL.COM

MAP TITLE: SITE PLAN & DRAINFIELD AREAS

PROJECT NAME: THE ORCHARDS LLC./THE ORCHARDS SUBDIVISION

LOCATION/DATE: PERTH ROAD, IREDELL COUNTY, NORTH CAROLINA, AUGUST 2006

JOB # : 01-1195
FILE: C:\JOBS\01-1195
PROJECT MGR.: C.B.F.
FIELD WORK: C.B.F.
DRAWN BY: C.B.F.