IREDELL COUNTY HEALTH DEPARTMENT

Statesville Office (704) 878-5305 Mooresville Office (704) 660-3625 PERMIT # 211367

IMPROVEMENT PERMIT / AUTHORIZATION TO CONSTRUCT / OPERATION PERMIT / EXISTING SYSTEM

PIN # 4649-15-3182

APPLICANT: DAVID BAILEY APPLICANT ADDRESS: 150 ORCHARD FARM LN

SITE ADDRESS: SAME PHONE: 704-806-0490 ALT. PHONE:

SITE DIRECTIONS: PERTH, TR WILD CHERRY, TL ORCHARD FARM, C END ON R

SUBDIVISION: THE ORCHARD SECTION: LOT # 14 LOT AREA: .65 AC DESIGN FLOW: L.T.A.R.:

Septic Tank (gal) STB Date
Pump Tank (gal) PT Date
Pump Make Model EXISTING Serial #
Nitrification Fields # Lines Linear Ft:
Trench Width Max. Trench Bottom Depth Gravel Depth

☐ New System ☐ Repair ☐ Expansion System Type: I II III IV V VI
System Description: LP-PANEL BLOCK
Repair System Description: PANEL BLOCK
Maintenance Agreement Required: ☑ YES ☐ NO
☐ GRAVITY ☒ PRESSURE

☐ Residence No. Bedrooms
☐ Business No. Persons
☒ Other No. Employees
☐ Slab ☐ Crawl Space
☐ Basement w/plumbing ☐ Basement w/o plumbing

Water Supply: ☒ Private ☐ Public ☐ Community


Comments / Conditions:

SHED

INITIAL SITE SKETCH

ORCHARD FARM LN.

AS BUILT SKETCH

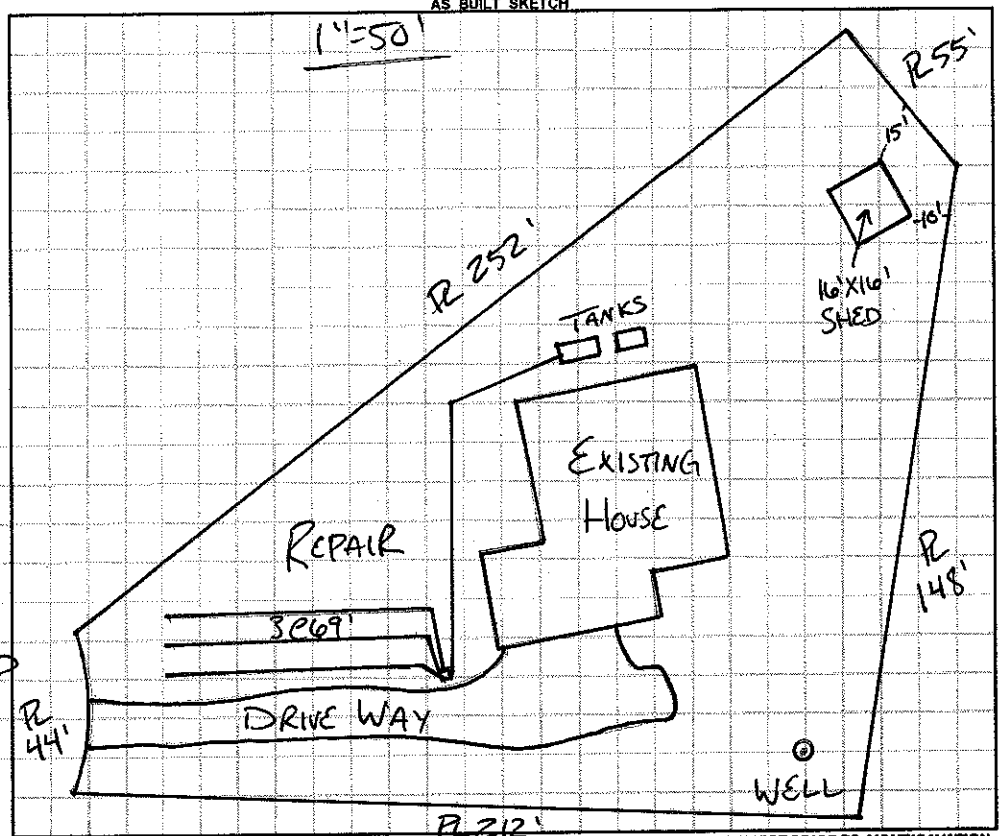

Permit can be suspended or revoked if any false information is supplied toward securing the permit / any unauthorized changes are made to the site / any unauthorized changes are made in the installation of the system. **CONTACT A LOCATOR SERVICE PRIOR TO ANY EXCAVATION**

☐ **IMPROVEMENT PERMIT** *with plat valid without expiration.* ☐ **IMPROVEMENT PERMIT** *with site plan valid for 60 mos.* ☐ **AUTHORIZATION TO CONSTRUCT** *valid for period equal to IMPROVEMENT PERMIT--not to exceed 60 mo.*

Owner / Applicant Signature: David Bailey Date: 2-7-15 Installed by:

IMPROVEMENT PERMIT by: Date: OPERATION PERMIT by: Date:

AUTHORIZATION TO CONSTRUCT by: Date: Existing System Inspected by: RA Date: APPROVED JUN 25 2015

Health Dept. Copy - WHITE Applicant (Final Approval) - YELLOW Applicant (Conditional Approval) - PINK