IREDELL COUNTY HEALTH DEPARTMENT

STATESVILLE 704-878-5305 MOORESVILLE 704-664-5281

1:00

IMPROVEMENT PERMIT / CERTIFICATE OF COMPLETION / OPERATION PERMIT / EXISTING SYSTEM INSPECTION

PROPERTY DESCRIPTION NO. 067943 DATE 7/18/97 TAX MAP NO. 4649152943 Watershed: ☑ Yes ☐ No

OWNER OR CONTRACTOR GARY RAYMOND PHONE: Business _____ Home 391-5704

ADDRESS 3616 RODWELL RD LOT 16

LOCATION PERTH RD - TR KNOTTY PINE - TR AT # 150 KNOTTY PINE

SUBDIVISION — BLOCK / SECTION — LOT — LOT AREA 5.999AC SITE CLASS. RS DESIGN FLOW 240 L.T.A.R. .2 GPD/FT²

Septic Tank: 1000 Gallons; STB 1007 Date 6/26/97

Pump Tank: _____ Gallons; PT _____ Date _____

Pump Make: _____ Model _____ Serial No. _____

Nitrification Field: No Fields 1 Square Feet 1200 Linear Feet 400

No Lines 4 @ 100' Trench Width 36" Max Trench Bottom Depth 18" Gravel Depth 12"

☑ New System ☐ Repair System Type: I, (II), III, IV, V, VI

System Description: GRAVITY CONVENTIONAL

Repair System Description: LPP

Maintenance Agreement Required: ☐ Yes ☑ No

☐ House/Mod. Home No. Bedrooms 2

☑ Mobile Home No. Bathrooms 2

☐ Business No. Employees _____

☐ Other _____


☐ Slab ☑ Crawl Space ☐ Basement w/plumbing ☐ Basement wo/plumbing

Water Supply: ☑ Individual ☐ Community ☐ Public

Comments:

Comments: Well Not installed at time of INSPECTION

INITIAL SITE SKETCH NOT TO SCALE 5.999AC

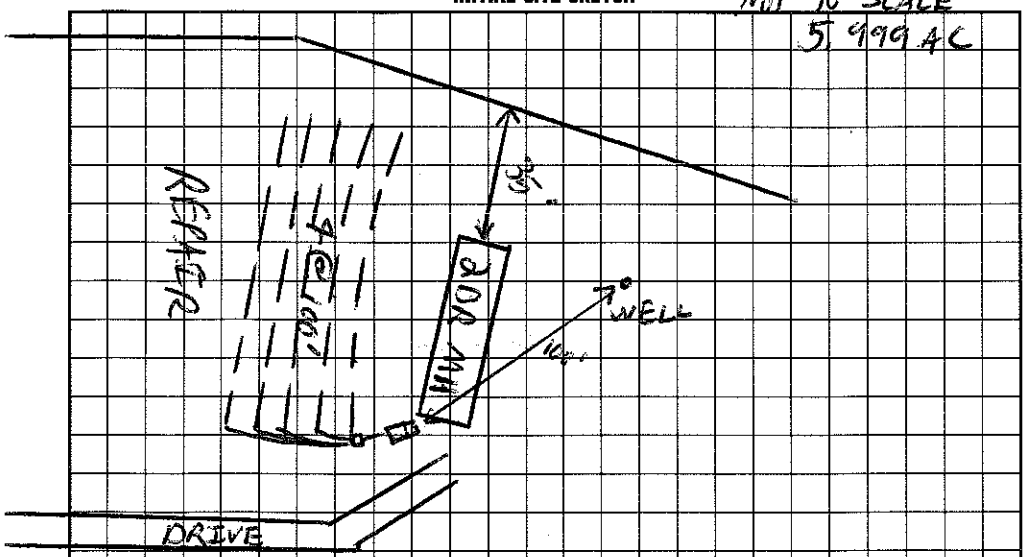

AS BUILT SKETCH

Installed as drawn Trenches were 18"

I understand that this permit can be suspended or revoked if any false information is supplied toward securing the permit/any unauthorized changes are made to the site/any unauthorized changes are made in the installation of the system. Improvement Permit is valid for 60 months from date of issuance.

Signed: Gary T. Raymond 7/22/97

Improvement Permit by: [signature] date 7/18/97

Existing System Inspection by: [signature] date 7/18/97

Installed by: Wayne Clontz

Certificate of Completion by: Maria Dotson date 8/11/97

Operation Permit by: Maria Dotson date 8/11/97

HEALTH DEPT. COPY: WHITE INSPECTION COPY (FINAL): GREEN OWNER COPY (FINAL): YELLOW INSPECTION COPY (INITIAL): PINK OWNER COPY (INITIAL): GOLD