IREDELL COUNTY HEALTH DEPARTMENT

→ AUTHORIZATION TO CONSTRUCT

STATESVILLE 704-878-5305 MOORESVILLE 704-664-5281

IMPROVEMENT PERMIT / ~~CERTIFICATE OF COMPLETION~~ / OPERATION PERMIT / EXISTING SYSTEM INSPECTION

PROPERTY DESCRIPTION NO. 24837 DATE 9/15/96 TAX MAP NO. 3E-10-A-[redacted]2 Watershed: ☑ Yes ☐ No

OWNER OR CONTRACTOR DEBRA BOWERS PHONE: Business 4649-17-0050 Home 376-5207

ADDRESS 152 ROYAL PT WAY, MOORESVILLE 28115

LOCATION PERTH RD N-TR FERN HILL TR DORCHESTER - [redacted] LOT AT END

SUBDIVISION OVERLASH PROP BLOCK / SECTION ____ LOT 2 LOT AREA .65 AC SITE CLASS. RS DESIGN FLOW 300GD L.T.A.R. 1360 PD FT²

Septic Tank: 1000 Gallons; STB 794 Date 2/9/96

Pump Tank: ____ Gallons; PT ____ Date ____

Pump Make: ____ Model ____ Serial No. ____

Nitrification Field: No. Fields 1 Square Feet 1200 Linear Feet 400

No. Lines 4 5 Trench Width 36" Max Trench Bottom Depth 36" Gravel Depth 12"

☑ New System ☐ Repair System Type: I, II, III, IV, V, VI

System Description: GRAVITY CONVENTIONAL

Repair System Description: GRAVITY CHANGERED

Maintenance Agreement Required: ☐ Yes ☑ No

☐ House/Mod. Home No. Bedrooms 3

☑ Mobile Home No. Bathrooms 2

☐ Business No. Employees ____

☐ Other ____

☐ Slab ☑ Crawl Space ☐ Basement w/plumbing ☐ Basement wo/plumbing


Water Supply: ☑ Individual ☐ Community ☐ Public

Comments:

Comments:

INITIAL SITE SKETCH

1" = 50'

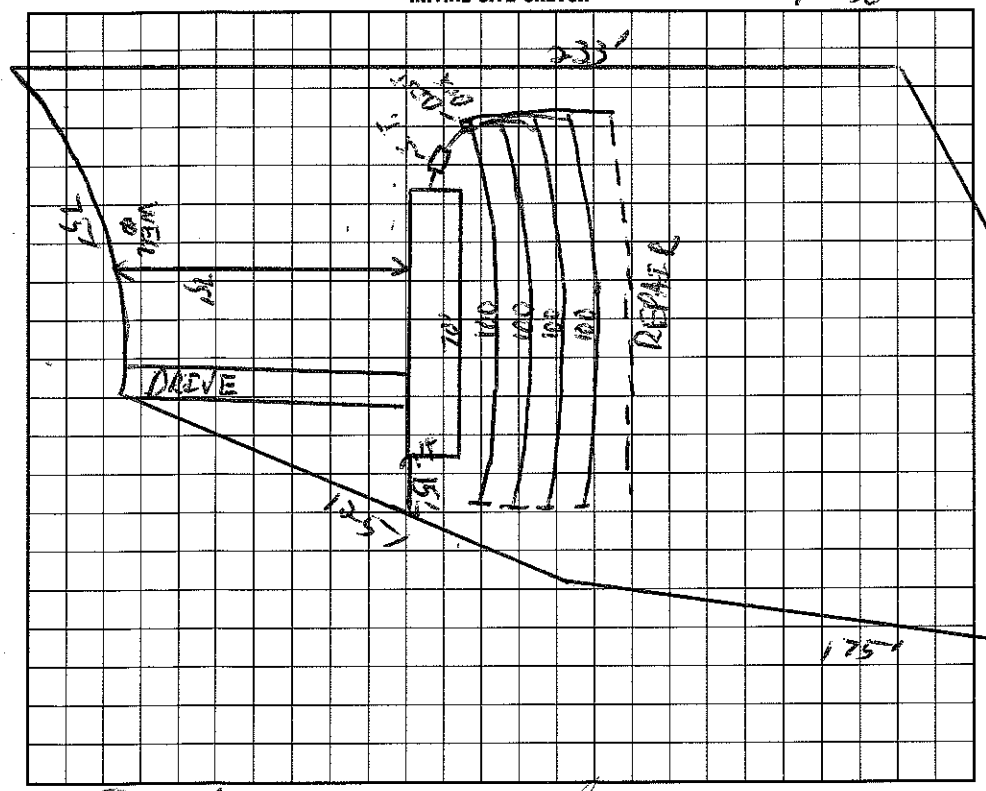

AS BUILT SKETCH

I understand that this permit can be suspended or revoked if any false information is supplied toward securing the permit/any unauthorized changes are made to the site/any unauthorized changes are made in the installation of the system.

Signed: Debra Bowers

Improvement Permit by: [signature] EHS.C date 9/15/96

AUTH. TO CONSTRUCT Existing System Inspection by: [signature] EHSD date 9/18/96

Installed by: Tim Simmons

Certificate of Completion by: ____ date ____

Operation Permit by: Wesley Sparks R.S. date 11/6/96

HEALTH DEPT. COPY: WHITE INSPECTION COPY (FINAL): GREEN OWNER COPY (FINAL): YELLOW INSPECTION COPY (INITIAL): PINK OWNER COPY (INITIAL): GOLD