IREDELL COUNTY HEALTH DEPARTMENT

AUTHORIZATION TO CONSTRUCT

STATESVILLE 704-878-5305 MOORESVILLE 704-664-5281

IMPROVEMENT PERMIT / ~~CERTIFICATE OF COMPLETION~~ / OPERATION PERMIT / EXISTING SYSTEM INSPECTION

PROPERTY DESCRIPTION NO. 070039 DATE 11/26/97 TAX MAP NO. ~~4649-17-3279~~ Watershed: ☑ ~~Yes~~ ☐ No

OWNER OR CONTRACTOR JOHN WILSON PHONE: Business 4649-17-3279 Home —

ADDRESS 395 FERN HILL RD TROUTMAN NC 28166

LOCATION PERTH RD TO FERN HILL - ~~TURN RIGHT~~ ON RT 64 CARLYLE RD

SUBDIVISION OVERCASH BLOCK / SECTION ____ LOT 9 LOT AREA 1.50 AC SITE CLASS. PS DESIGN FLOW 360 L.T.A.R. --

Septic Tank: EXISTING Gallons; STB ____ Date ____

Pump Tank: ____ Gallons; PT ____ Date ____

Pump Make: ____ Model ____ Serial No. ____

Nitrification Field: No Fields 1 Square Feet 300 Linear Feet 100

No Lines 2 @ 50' Trench Width 36" Max Trench Bottom Depth ~~22~~ Gravel Depth 12"

☑ New System ☐ Repair System Type: I, (II), III, IV, V, VI

System Description: GRAVITY CONVENTIONAL

Repair System Description: PUMP CONVENTIONAL

Maintenance Agreement Required: ☐ Yes ☑ ~~No~~

☐ House/Mod. Home No. Bedrooms 3

☑ Mobile Home No. Bathrooms 2

☐ Business No. Employees ____

☐ Other ____

☐ Slab ☑ Crawl Space ☐ Basement w/plumbing ☐ Basement wo/plumbing


Water Supply:
☑ Individual
☐ Community
☐ Public

Comments: AS NEEDED

Comments:

INITIAL SITE SKETCH

NOT TO SCALE

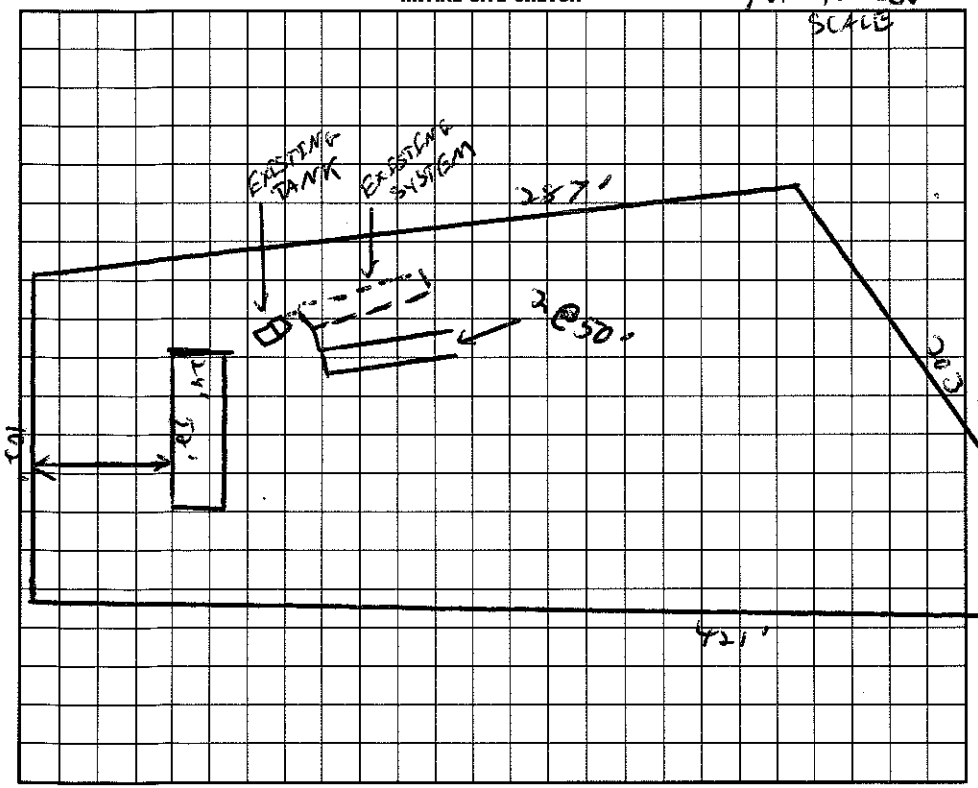

AS BUILT SKETCH

I understand that this permit can be suspended or revoked if any false information is supplied toward securing the permit/any unauthorized changes are made to the site/any unauthorized changes are made in the installation of the system. Improvement Permit is valid for 60 months from date of issuance.

Signed: Russell Wilson

Improvement Permit by: C. Ray Tarlton RS date 11/26/97

AUTHORIZATION TO ~~Existing System Inspection by:~~ CONSTRUCT C. Ray Tarlton RS date 11/26/97

Installed by: A1 BACKHOE

Certificate of Completion by: ____ date ____

Operation Permit by: C. Ray Tarlton date 12/19/97

HEALTH DEPT. COPY: WHITE INSPECTION COPY (FINAL): GREEN OWNER COPY (FINAL): YELLOW INSPECTION COPY (INITIAL): PINK OWNER COPY (INITIAL): GOLD