IREDELL COUNTY HEALTH DEPARTMENT

Statesville Office (704) 878-5305 | Mooresville Office (704) 660-3625 | PERMIT # 223761

IMPROVEMENT PERMIT / AUTHORIZATION TO CONSTRUCT / OPERATION PERMIT / EXISTING SYSTEM

PIN # 4649.17.32.7791

APPLICANT: Mike Shea | APPLICANT ADDRESS: 251 Lake Mist Dr Mooresville NC

SITE ADDRESS: 425 Fern Hill Rd - Troutman NC | PHONE: 704-779-9969 | ALT. PHONE: N/A

SITE DIRECTIONS: 150 T/R Perth Rd T/R Fern Hill Rd house on right


SUBDIVISION: RF Overcash | SECTION: N/A | LOT # 7 | LOT AREA: 1.1 ac | DESIGN FLOW: 360 | L.T.A.R.: Ey

Septic Tank	Exist (gal)	STB		Date		☐ New System ☐ Repair ☐ Expansion	System Type: I ☒ II III IV V VI	☒ Residence	No. Bedrooms 3
Pump Tank	(gal)	PT		Date		System Description: Existing		☐ Business	No. Persons 6
Pump Make		Model		Serial #		Repair System Description:		☐ Other	No. Employees
# Nitrification Fields	Ey	# Lines	Ey	Linear Ft:	Ey	Maintenance Agreement Required:	☐ YES ☒ NO	☐ Slab	☒ Crawl Space
Trench Width	Ey	Max. Trench Bottom Depth	Ey	Gravel Depth		☒ GRAVITY	☐ PRESSURE	☐ Basement w/plumbing	☐ Basement w/o plumbing


Water Supply: ☐ Private ☐ Public ☒ Community

Comments / Conditions: Maintain 5' off any part of STS + 25' off any well.

INITIAL SITE SKETCH

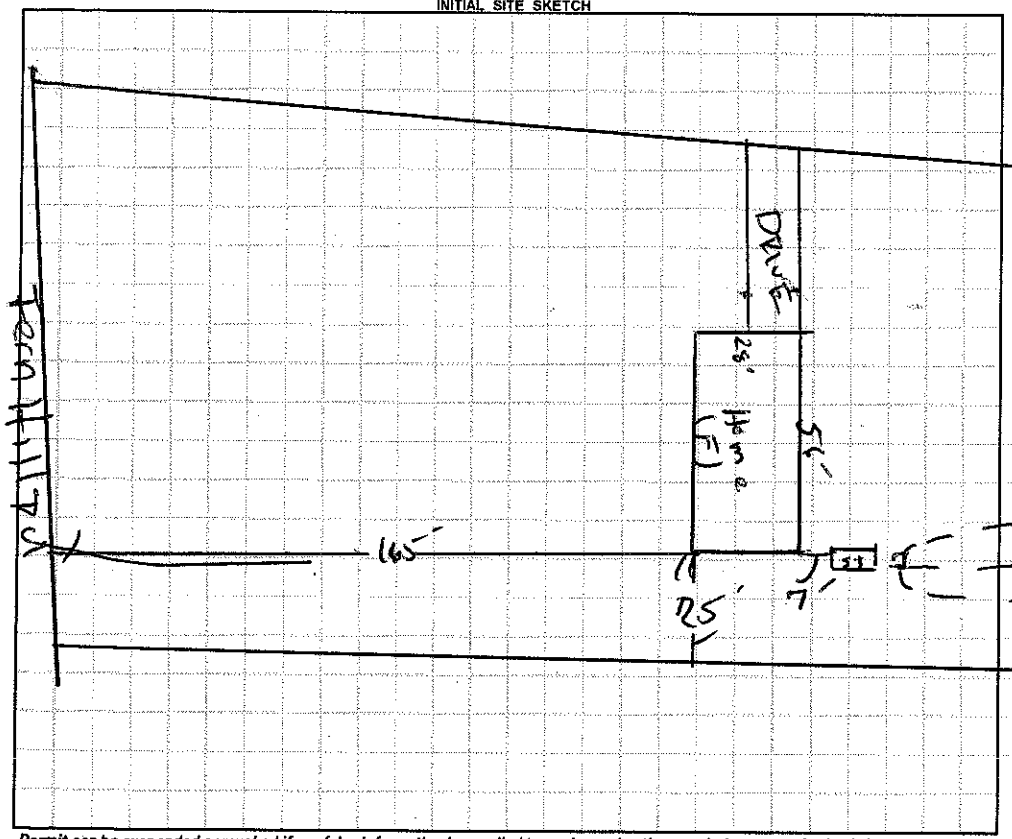

AS BUILT SKETCH

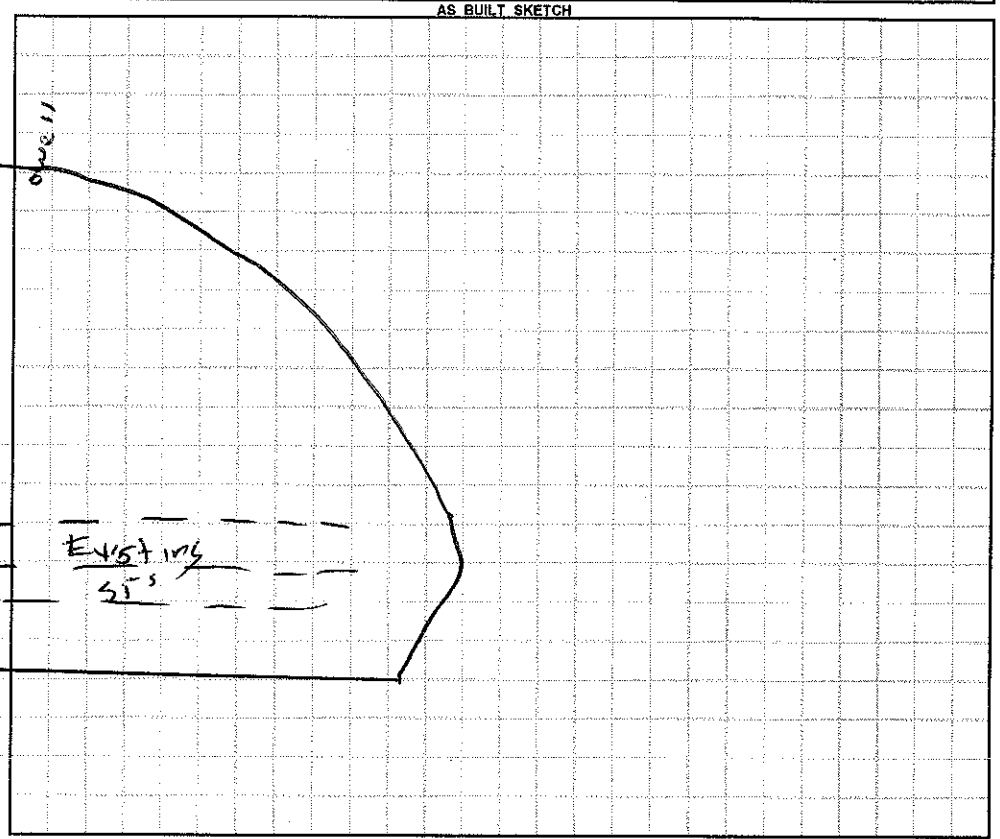

Permit can be suspended or revoked if any false information is supplied toward securing the permit / any unauthorized changes are made to the site / any unauthorized changes are made in the installation of the system. **CONTACT A LOCATOR SERVICE PRIOR TO ANY EXCAVATION**

☐ **IMPROVEMENT PERMIT** *with plat valid without expiration.* ☐ **IMPROVEMENT PERMIT** *with site plan valid for 60 mos.* ☐ **AUTHORIZATION TO CONSTRUCT** *valid for period equal to IMPROVEMENT PERMIT--not to exceed 60 mo.*

Owner / Applicant Signature: [signature] Date: 12-5-16 Installed by:

IMPROVEMENT PERMIT by: Date: OPERATION PERMIT by: Date:

AUTHORIZATION TO CONSTRUCT by: Date: Existing System Inspected by: [signature] Date: 12/2/16

Health Dept. Copy - WHITE Applicant (Final Approval) - YELLOW Applicant (Conditional Approval) - PINK