IREDELL COUNTY HEALTH DEPARTMENT

STATESVILLE 704-878-5305 MOORESVILLE 704-664-5281

IMPROVEMENT PERMIT / AUTHORIZATION TO CONSTRUCT / OPERATION PERMIT / EXISTING SYSTEM INSPECTION

PERMIT# 94646/11738 PIN# ~~4649-17-5006 PI~~ 4649171239 DATE 1/23/04

OWNER OR CONTRACTOR Charles Wilhelm PHONE: Business (828) 328-4681 Home

ADDRESS 3720 10th St. Dr NE Hickory NC 28601

LOCATION Perth, R Fern Hill, at corner Dorchester

SUBDIVISION Shug Acres BLOCK / SECTION LOT 11 LOT AREA 0.513 AC SITE CLASS A5 DESIGN FLOW 360 L.T.A.R. 0.35

Septic Tank: 1000 Gallons; STB 1007 Date 11/10/03
Pump Tank: Gallons; PT Date
Pump Make: Model Serial No.
Nitrification Field: No Fields 1 Square Feet 780 Linear Feet 260
No Lines 2@130 Trench Width 36" Max Trench Bottom Depth 36" Gravel Depth —

☒ New System ☐ Repair System Type: I, II, III, IV, V, VI
System Description: Gravity 25% Reduct.
Repair System Description: Pump Panel Block
Maintenance Agreement Required: ☐ Yes ☐ No


☐ House/Mod. Home No. Bedrooms
☐ Mobile Home No. Bathrooms
☐ Business No. Employees
☐ Other
☐ Slab ☐ Crawl Space ☐ Basement w/plumbing ☐ Basement wo/plumbing

Water Supply:
☐ Individual
☐ Public
☐ Community

Comments:/Conditions:

Comments:/Conditions:
well

INITIAL SITE SKETCH

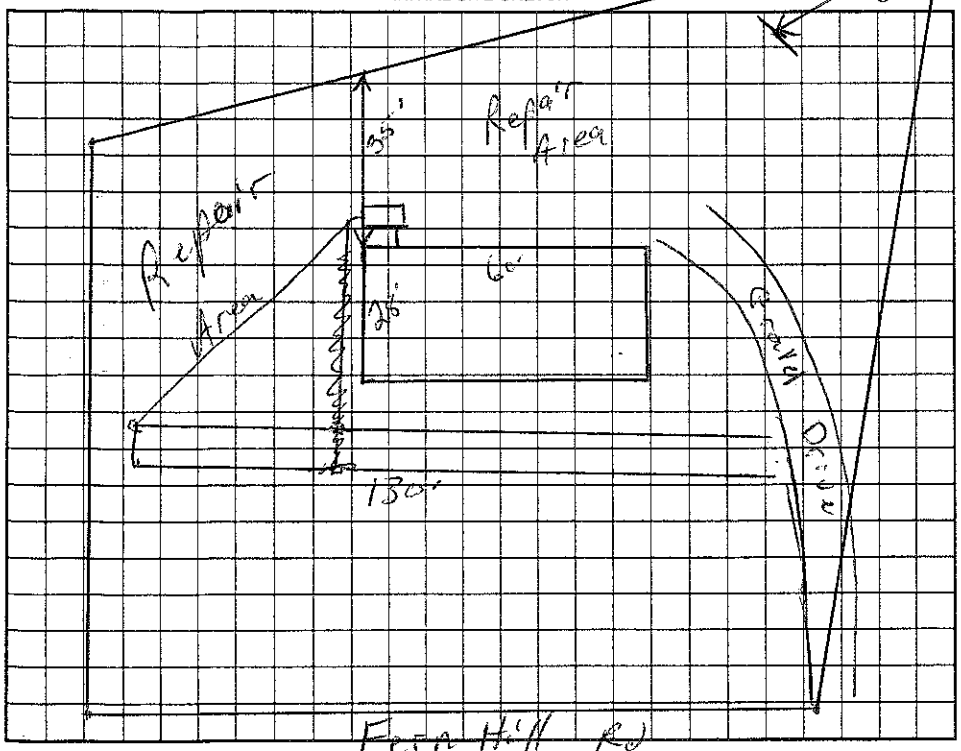

AS BUILT SKETCH

Infiltrators Installed

Permit can be suspended or revoked if any false information is supplied toward securing the permit/any unauthorized changes are made to the site/any unauthorized changes are made in the installation of the system. Improvement Permit with plat valid without expiration. Improvement Permit with site plan valid for sixty months. Authorization to Construct is valid for a period equal to that of Improvement Permit – not to exceed sixty months.

Signed: Wayne Clontz date

Improvement Permit by: RS date 1/23/04

Authorization to Construct by: RS date 1/23/04

Installed by: Wayne Clontz

Operation Permit by: RS date 2-2-04

Existing System Inspection by: date

(HEALTH DEPT. COPY: WHITE) (OWNER COPY (FINAL): YELLOW) (OWNER COPY (INITIAL): PINK)