# IREDELL COUNTY HEALTH DEPARTMENT

STATESVILLE 704-878-5305 (10:00) MOORESVILLE 704-664-5281

## IMPROVEMENT PERMIT / AUTHORIZATION TO CONSTRUCT / OPERATION PERMIT / EXISTING SYSTEM INSPECTION

PERMIT# 075982 PIN# 4648393508PT 4649209261 DATE 9/25/98

OWNER OR CONTRACTOR Frank & Reba Moore Freedom Homes PHONE: Business 528-9449 Home

ADDRESS 1018 Charlotte Hwy. Troutman, NC 28166

LOCATION Hwy 21N TL Cornelius TR, Judas Rd. ½ Mile on left

SUBDIVISION Shade BLOCK / SECTION LOT 4 LOT AREA 28210 SITE CLASS. PS DESIGN FLOW 360gpd L.T.A.R. .3+

Septic Tank: 1000v Gallons; STB 101v Date 5-8-98

Pump Tank: Gallons; PT Date

Pump Make: Model Serial No.

Nitrification Field: No Fields 1 Square Feet 870 Linear Feet 290'

No Lines 4 Trench Width 36" Max Trench Bottom Depth 36" Gravel Depth N/A

☒ New System ☐ Repair System Type: I, II, III, IV, V, VI

System Description: Gravity - 25% Reduction

Repair System Description: Gravity/Pump Panel Blk

Maintenance Agreement Required: ☐ Yes ☒ No

☐ House/Mod. Home ☒ Mobile Home ☐ Business ☐ Other

No. Bedrooms 3 No. Bathrooms 2 No. Employees

☐ Slab ☒ Crawl Space ☐ Basement w/plumbing ☐ Basement wo/plumbing


Water Supply: ☒ Individual ☐ Public ☐ Community

Comments:/Conditions: Keep Septic System at least 50' from all Wells; Stay 10' from PL & 5' from House.

Comments:/Conditions:

### INITIAL SITE SKETCH

Scale 1:50

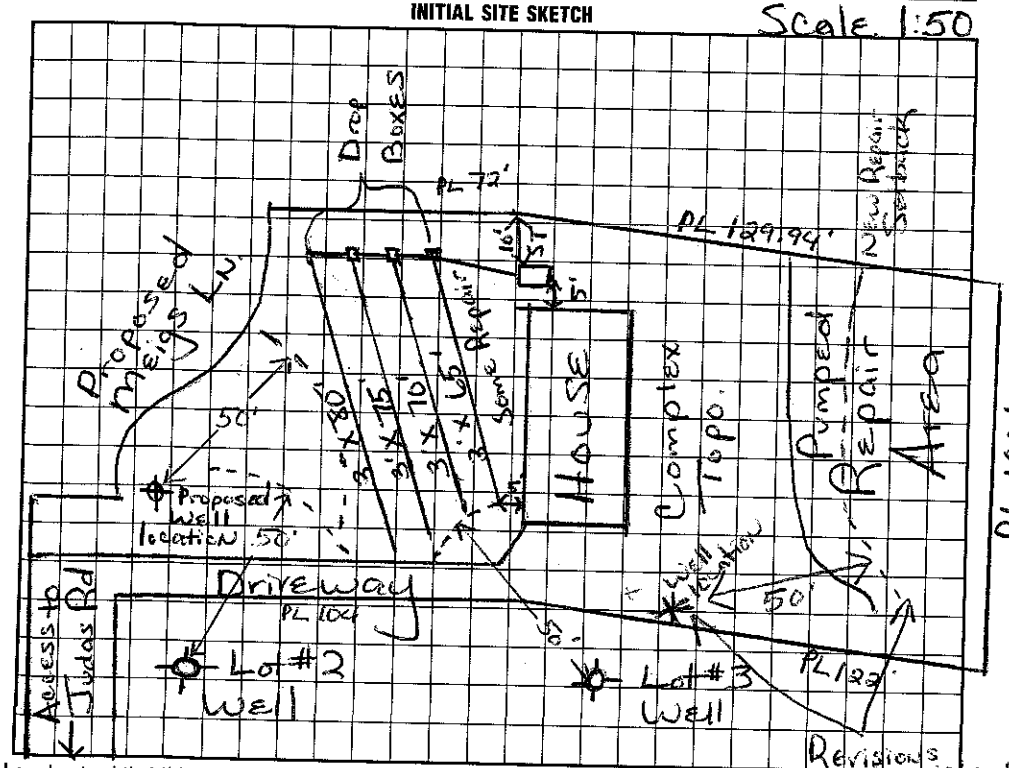


### AS BUILT SKETCH

I understand that this permit can be suspended or revoked if any false information is supplied toward securing the permit/any unauthorized changes are made to the site/any unauthorized changes are made in the installation of the system. Improvement Permit with plat valid without expiration. Improvement Permit with site plan valid for sixty months. Authorization to Construct is valid for a period equal to that of Improvement Permit – not to exceed sixty months.

Signed: date 9/25/98 Installed by: A-1 Backhoe

Improvement Permit by: Maria H. H. Dotson RS date 9/25/98 Operation Permit by: Wesley Sparks RS. date 10/7/98

Authorization to Construct by: Maria H. H. Dotson RS date 9/25/98 Existing System Inspection by: date

HEALTH DEPT. COPY: WHITE INSPECTION COPY (FINAL): GREEN OWNER COPY (FINAL): YELLOW INSPECTION COPY (INITIAL): PINK OWNER COPY (INITIAL): GOLD