IREDELL COUNTY HEALTH DEPARTMENT

/ Authorization to Construct (1:30) 4649218345

STATESVILLE 704-878-5305
MOORESVILLE 704-664-5281

IMPROVEMENT PERMIT / ~~CERTIFICATE OF COMPLETION~~ / OPERATION PERMIT / EXISTING SYSTEM INSPECTION

PROPERTY DESCRIPTION NO. 20830 DATE 8/7/96
OWNER OR CONTRACTOR Eva Dunnings TAX MAP NO. 25 A 330
ADDRESS 245 Judas Rd. Mooresville NC. 28115 PHONE: Business ______ Home 663-63711 Watershed: ☐ Yes ☒ No
LOCATION Cornelius Rd. TR Judas Rd. to third house on (R)
SUBDIVISION N/A BLOCK / SECTION ______ LOT ______ LOT AREA .71 SITE CLASS. PS DESIGN FLOW 360 L.T.A.R. .35

Septic Tank: 1000 Gallons; STB 825 Date 12/15/96
Pump Tank: ______ Gallons; PT ______ Date ______
Pump Make: ______ Model ______ Serial No. ______
Nitrification Field: No Fields 1 Square Feet 1028 Linear Feet 345
No Lines 4 Trench Width 36 Max Trench Bottom Depth 36" Gravel Depth 12"

☒ New System ☐ Repair System Type: I, (II), III, IV, V, VI
System Description: DIST BOX - CONV
Repair System Description: SAME
Maintenance Agreement Required: ☐ Yes ☒ No


☒ House/Mod. Home ☐ Mobile Home ☐ Business ☐ Other ______
No. Bedrooms 3
No. Bathrooms 2
No. Employees ______
☐ Slab ☒ Crawl Space ☐ Basement w/plumbing ☐ Basement wo/plumbing

Water Supply: ☒ Individual ☐ Community ☐ Public


Comments:

Comments:

INITIAL SITE SKETCH

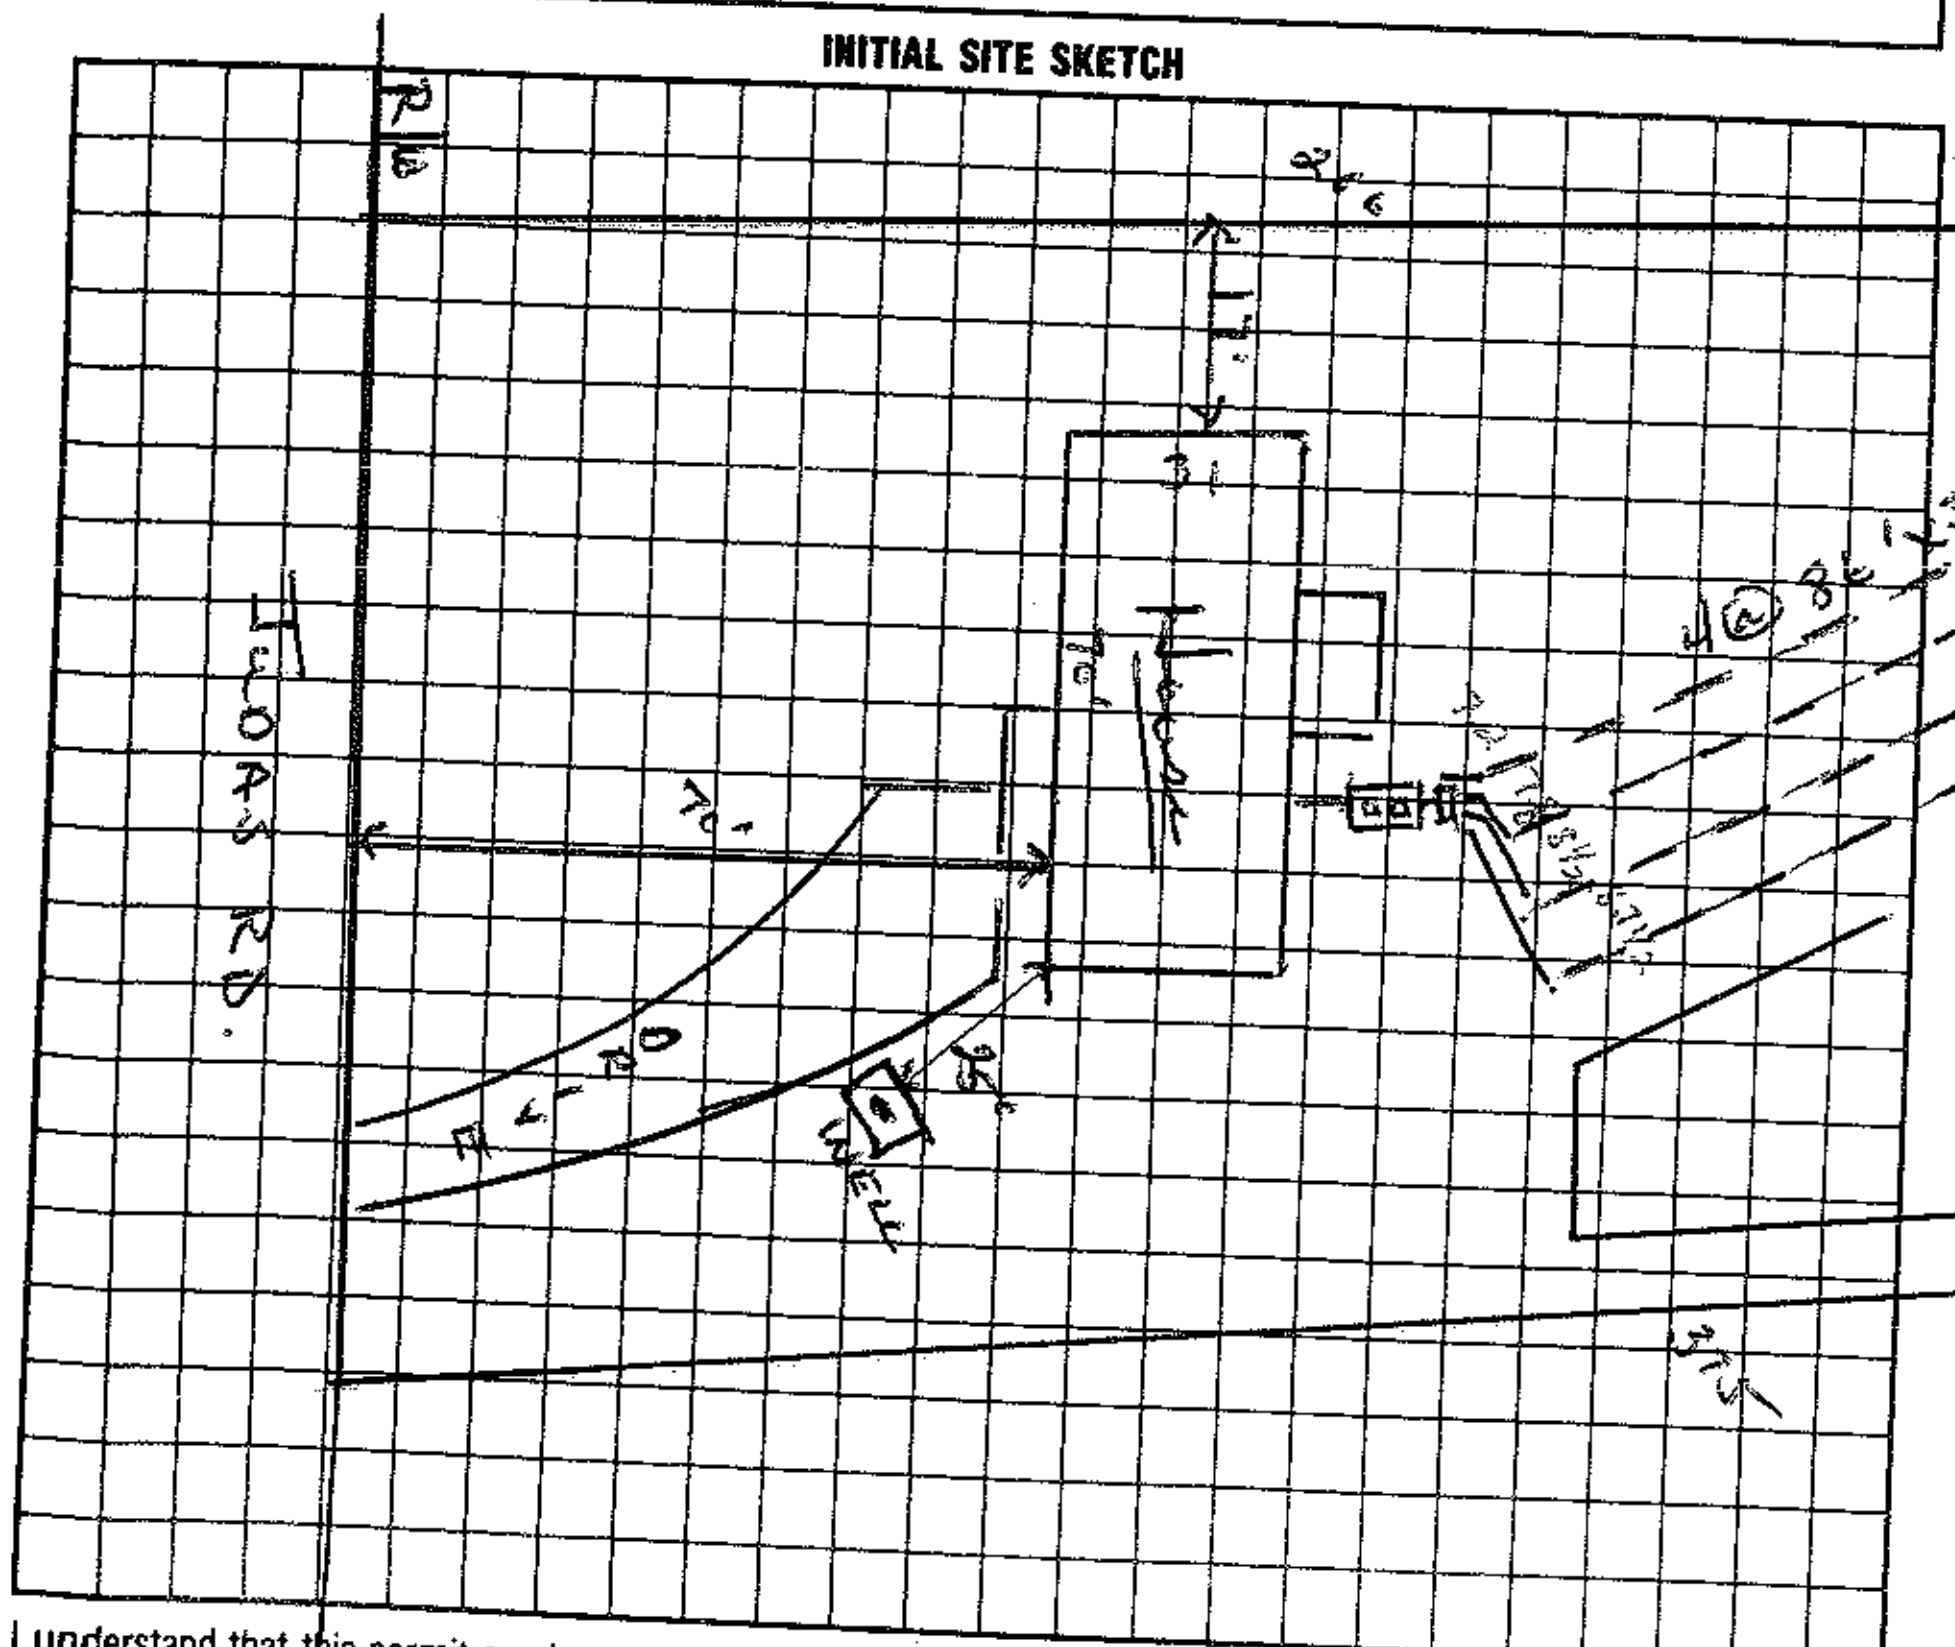

AS BUILT SKETCH

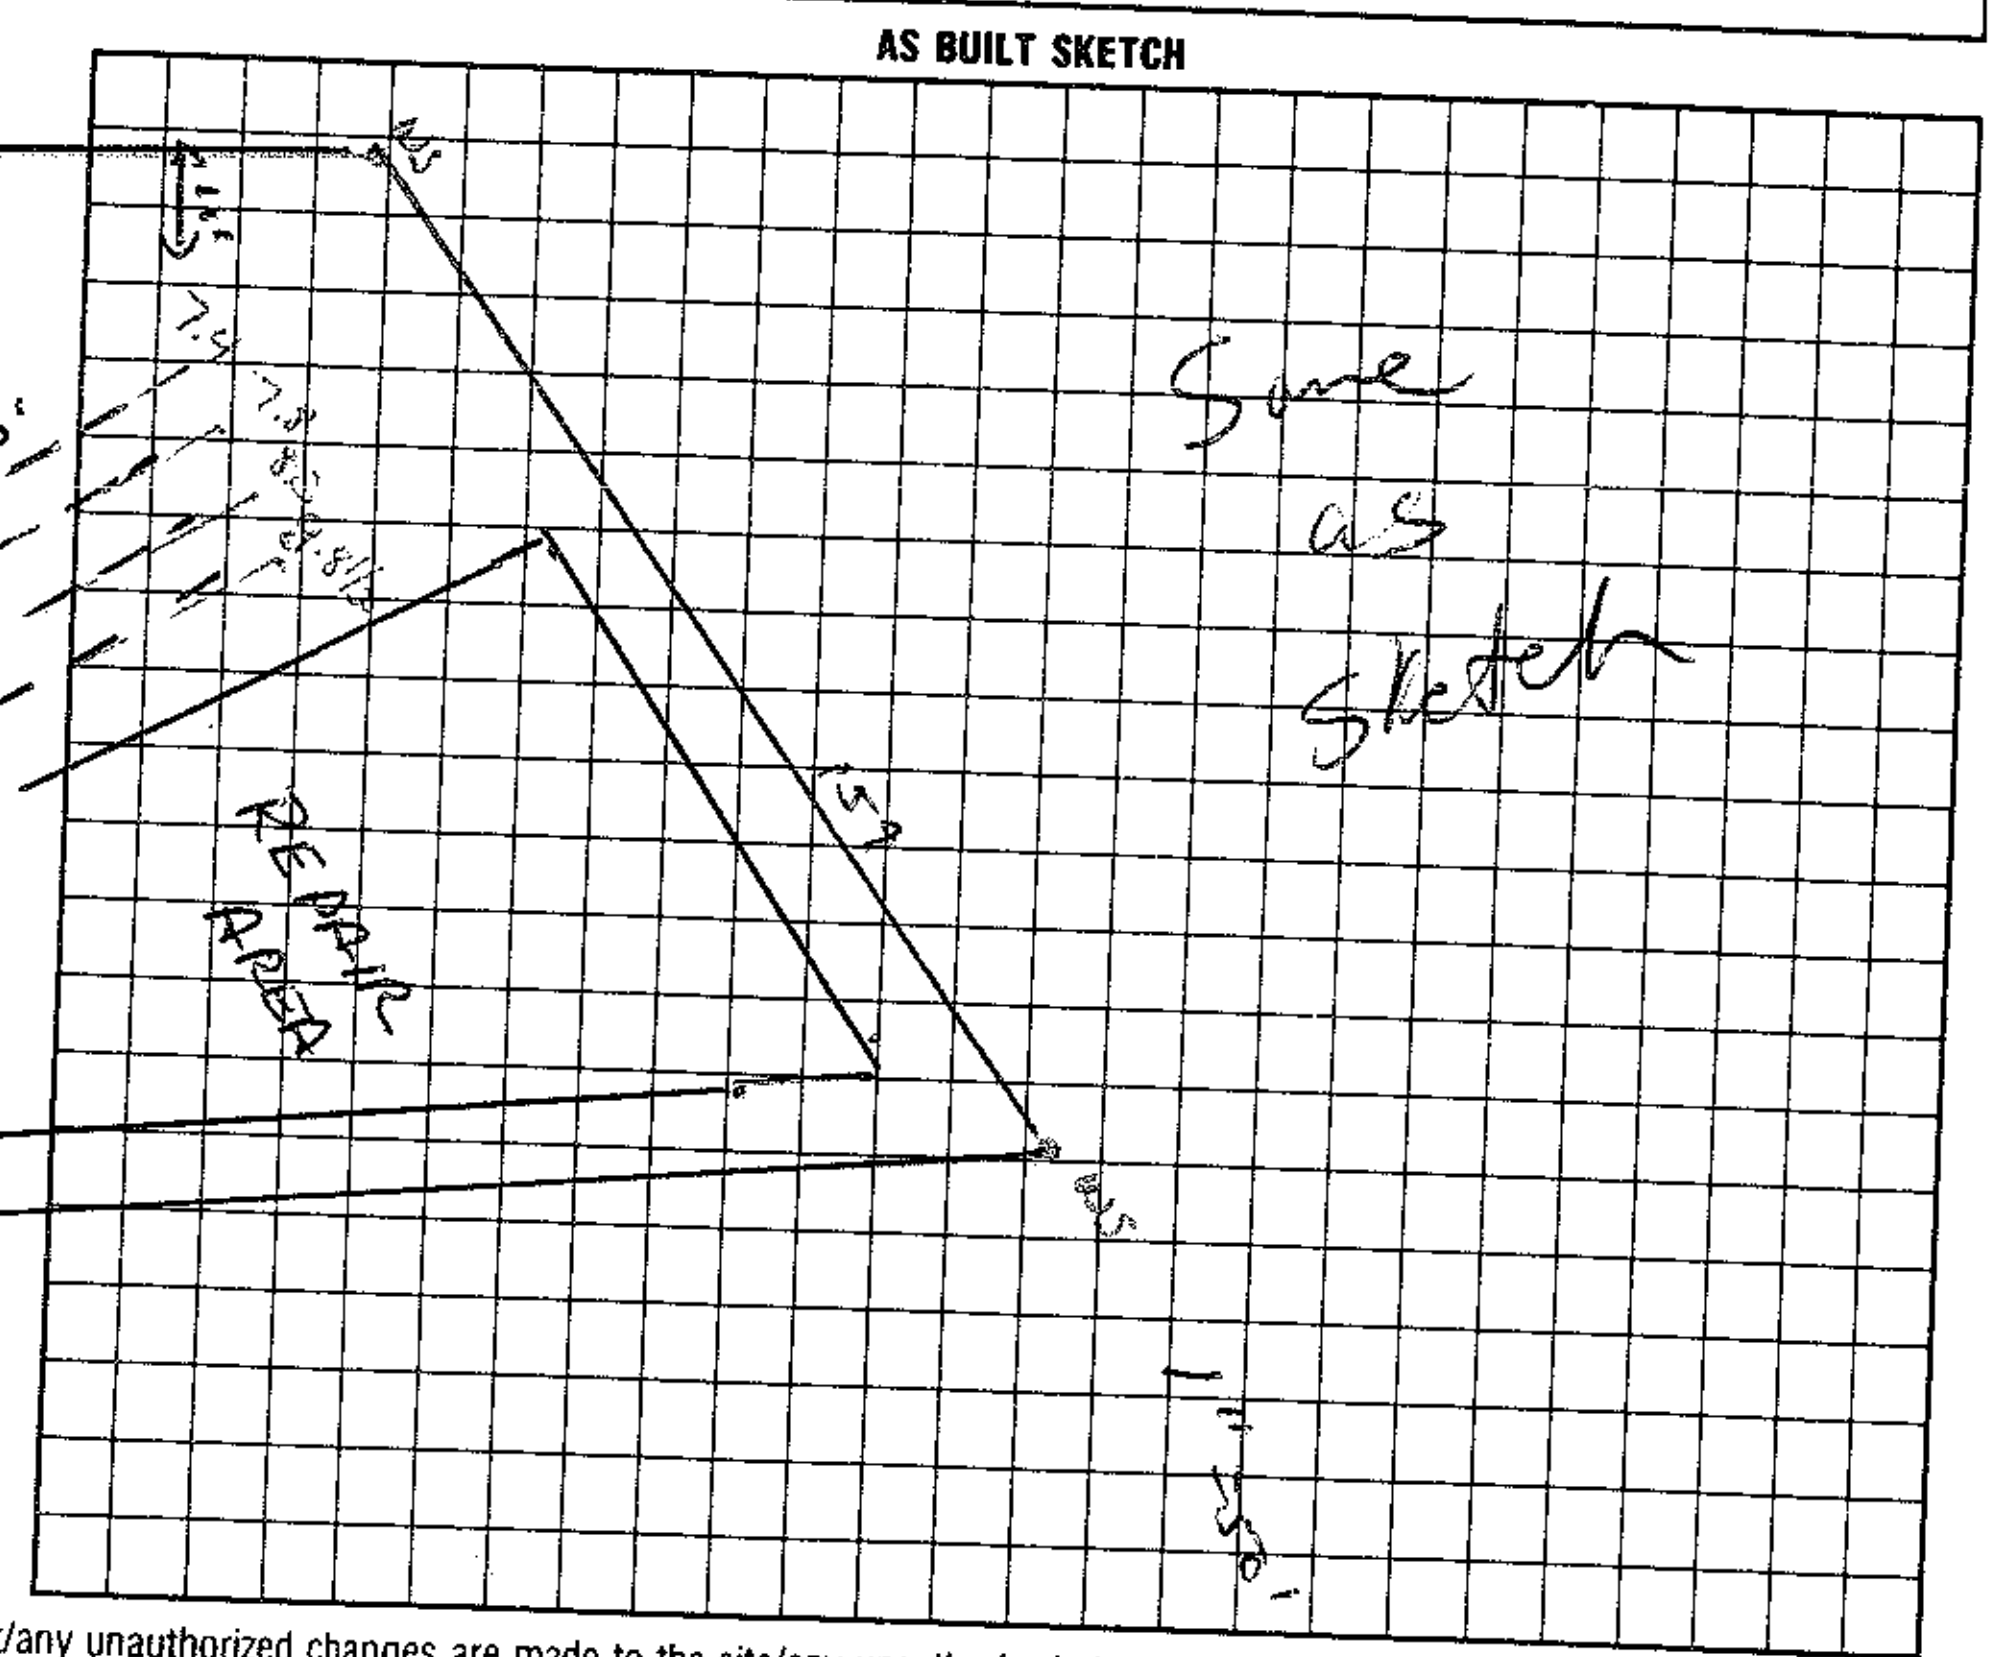

I understand that this permit can be suspended or revoked if any false information is supplied toward securing the permit/any unauthorized changes are made to the site/any unauthorized changes are made in the installation of the system.

Signed: * James Dunnings — Authorization to Construct valid 60 months.

Improvement Permit by: Wesley Sparks RS. date 8/7/96

~~Existing System Inspection by:~~ Auth To Construct Wesley Sparks RS. date 8/7/96

Installed by: MYERS SEPTIC

Certificate of Completion by: ______ date ______

Operation Permit by: [signature] date 3/11/97

HEALTH DEPT. COPY: WHITE INSPECTION COPY (FINAL): GREEN OWNER COPY (FINAL): YELLOW INSPECTION COPY (INITIAL): PINK OWNER COPY (INITIAL): GOLD