IREDELL COUNTY HEALTH DEPARTMENT

STATESVILLE 704-878-5305 MOORESVILLE 704-664-5281

IMPROVEMENT PERMIT / AUTHORIZATION TO CONSTRUCT / OPERATION PERMIT / EXISTING SYSTEM INSPECTION

PERMIT# 123273 PIN# 4649-27-1301 4649-27-1314 DATE April 22, 05

OWNER OR CONTRACTOR Corinthian Dev. Ltd. PHONE: Business _____ Home _____

ADDRESS P.O. Box 3421 Mooresville, N.C. 28117

LOCATION Portion of N TR Fern Hill on left at jct with Carlyle Road

SUBDIVISION The Ranches BLOCK / SECTION _____ LOT 5 Revised LOT AREA .76ac SITE CLASS. PS DESIGN FLOW 360gpd L.T.A.R. .25

Septic Tank: 1000 Gallons; STB 795 Date 3/11/05
Pump Tank: _____ Gallons; PT _____ Date _____
Pump Make: _____ Model _____ Serial No. _____
Nitrification Field: No Fields 1 Square Feet 1080 Linear Feet 360
No Lines 3@120' Trench Width 36" Max Trench Bottom Depth 36" Gravel Depth N/A

☒ New System ☐ Repair System Type: I II III IV V VI
System Description: Gravity 25% Reduction
Repair System Description: LPP BPS
Maintenance Agreement Required: ☐ Yes ☒ No (N/A utility)

☒ House/Mod. Home No. Bedrooms 3
☐ Mobile Home No. Bathrooms ____
☐ Business No. Employees ____
☐ Other _____

☒ Slab ☐ Crawl Space ☐ Basement w/plumbing ☐ Basement wo/plumbing


Water Supply: ☒ Individual ☐ Public ☐ Community

Comments:/Conditions: Must construct stormwater ditch where shown. House to be built on elevated slab and plumbing to exit no deeper than 6" from existing grade at septic tank location.

Comments:/Conditions: 8/9/05 System heavily rained in - Trenches need dug out after soil fully saturated removed and cleaned. AWS 8/10/05

1"=50'


INITIAL SITE SKETCH

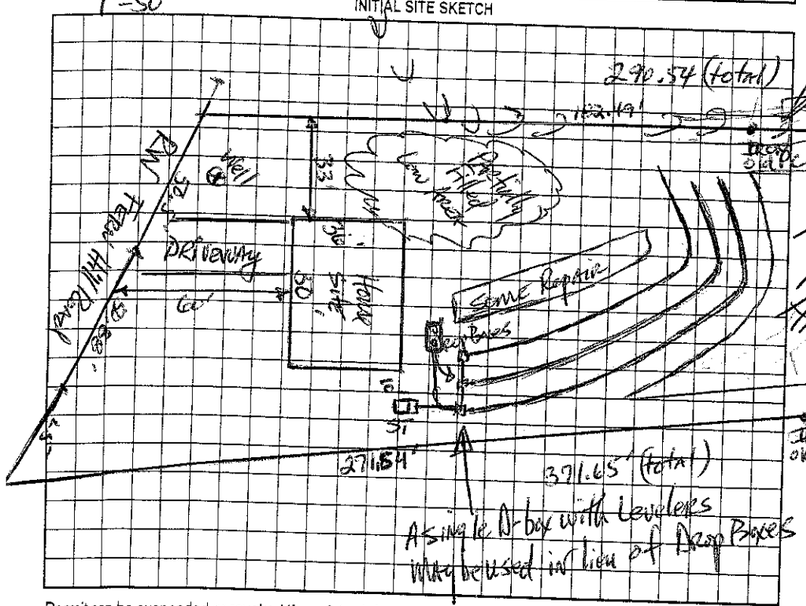

AS BUILT SKETCH

Shave off hump

Installer Shallow Stormwater ditch along S/L property line

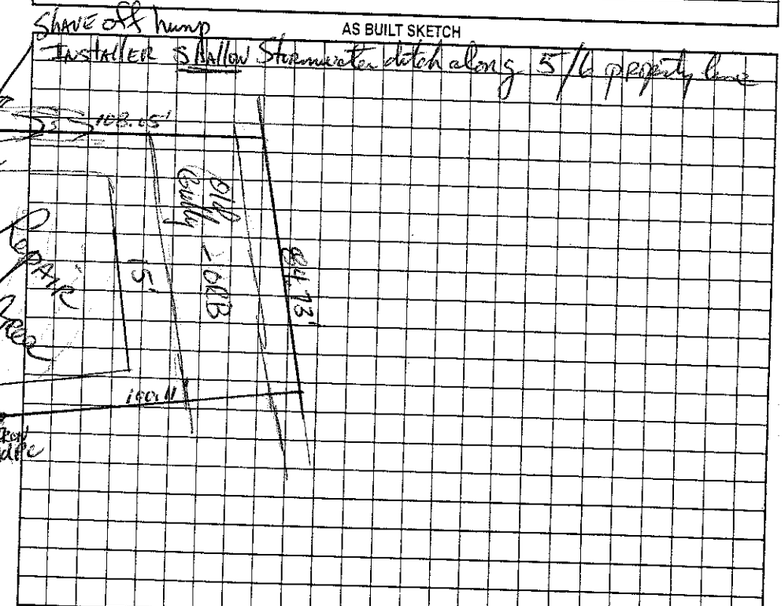

Permit can be suspended or revoked if any false information is supplied toward securing the permit/any unauthorized changes are made to the site/any unauthorized changes are made in the installation of the system. Improvement Permit with plat valid without expiration. Improvement Permit with site plan valid for sixty months. Authorization to Construct is valid for a period equal to that of Improvement Permit – not to exceed sixty months.

Signed: _____ date Apr 26 05

Improvement Permit by: _____ date 4-22-05

Authorization to Construct by: _____ date 4/25/05

Installed by: Corinthian Development

Operation Permit by: Wesley Sparks R.S. date 8/10/05

Existing System Inspection by: _____ date _____

HEALTH DEPT. COPY: WHITE OWNER COPY (FINAL): YELLOW OWNER COPY (INITIAL): PINK