IREDELL COUNTY HEALTH DEPARTMENT
IMPROVEMENT PERMIT / AUTHORIZATION TO CONSTRUCT / OPERATION PERMIT / EXISTING SYSTEM INSPECTION

STATESVILLE 704-878-5305 MOORESVILLE 704-664-5281

PERMIT# 089533 PIN# 4649 27 1727

OWNER OR CONTRACTOR Randy McDowell DATE 6/13/00

ADDRESS 239 Jasmine Circle Troutman, NC. 28166 PHONE: Business Home [redacted]-528-5985

LOCATION Flower House Loop TL Cox Rd TR Jasmine Cir TL Towne TL Jasmine 1st lot on (R)

SUBDIVISION KING ACRES BLOCK / SECTION LOT 15 LOT AREA .46 SITE CLASS. PS DESIGN FLOW 360 L.T.A.R. .3

Septic Tank: 1000 Gallons; STB 312 Date

Pump Tank: Gallons; PT Date

Pump Make: Model Serial No.

Nitrification Field: No Fields 1 Square Feet 1200 Linear Feet 400

No Lines 5@80'x3' Trench Width 36" Max Trench Bottom Depth 36" Gravel Depth 12"

☒ New System ☐ Repair System Type: I, (II), III, IV, V, VI

System Description: Drew-Conventional

Repair System Description: Same

Maintenance Agreement Required: ☐ Yes ☒ No

☐ House/Mod. Home ☒ Mobile Home ☐ Business ☐ Other


No. Bedrooms 3 No. Bathrooms 2 No. Employees

☐ Slab ☒ Crawl Space ☐ Basement w/plumbing ☐ Basement wo/plumbing

Water Supply: ☐ Individual ☐ Public ☒ Community

Comments:/Conditions:


(1" = 40') INITIAL SITE SKETCH

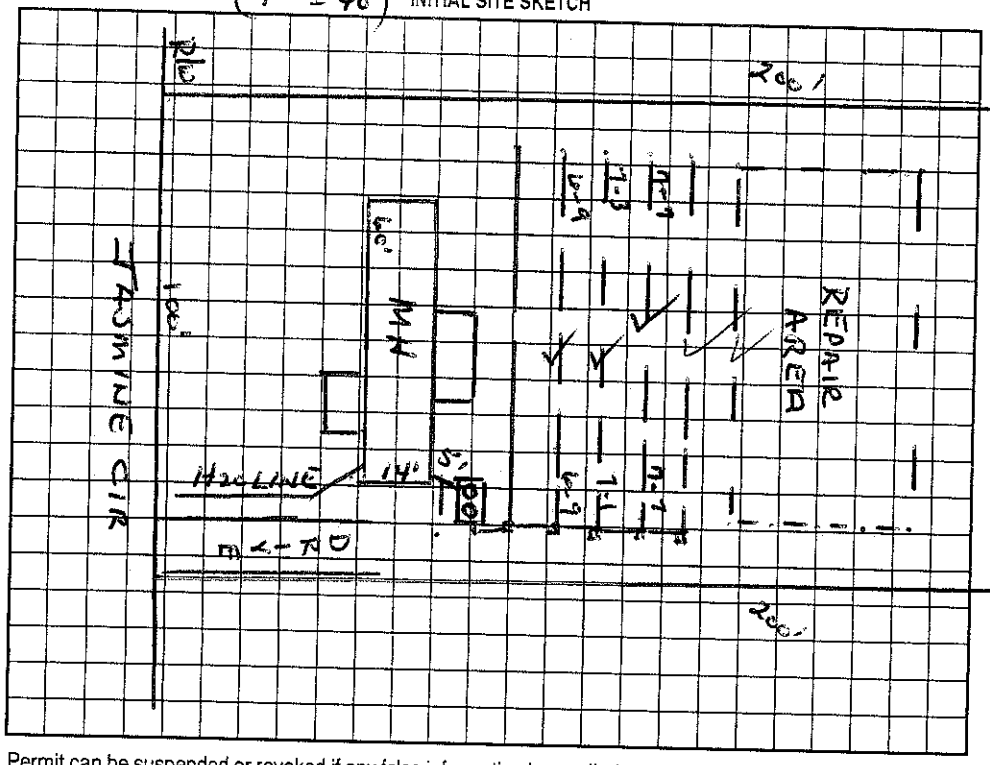

Comments:/Conditions:

Installed as Drawn

AS BUILT SKETCH

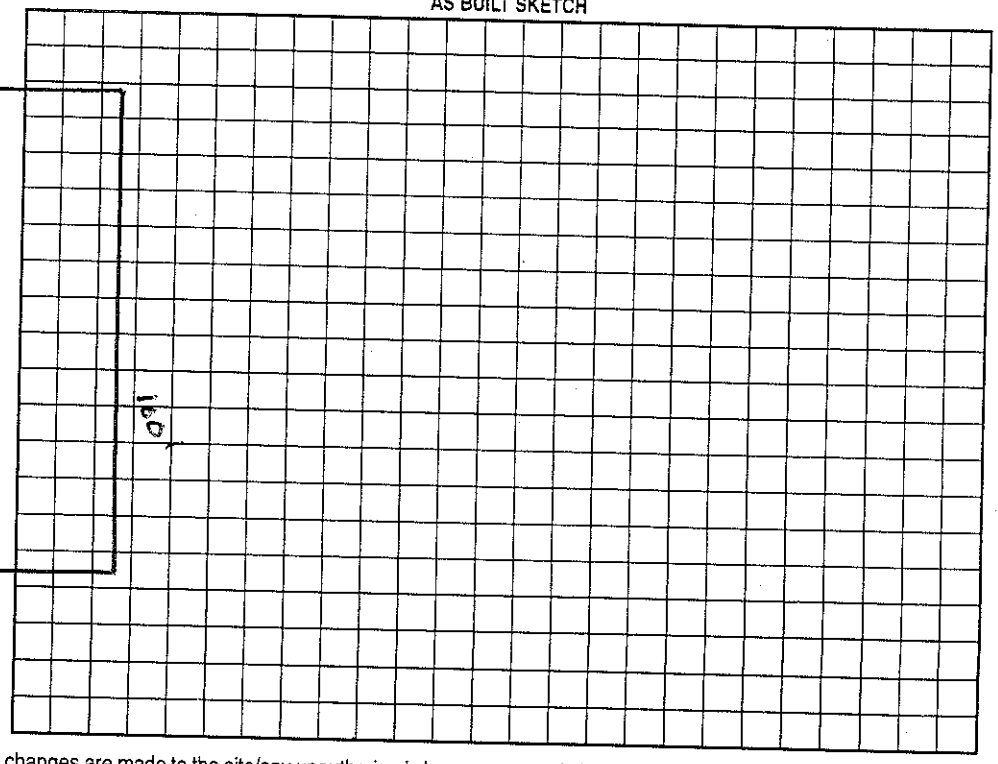

Permit can be suspended or revoked if any false information is supplied toward securing the permit/any unauthorized changes are made to the site/any unauthorized changes are made in the installation of the system. Improvement Permit with plat valid without expiration. Improvement Permit with site plan valid for sixty months. Authorization to Construct is valid for a period equal to that of Improvement Permit – not to exceed sixty months.

Signed: Randy W. McDowell date 10-15-00 Installed by: Randy McDowell

Improvement Permit by: Wesley Sparks RS. date 6/13/00 Operation Permit by: Maria H. Dotson date 10/6/2000

Authorization to Construct by: Wesley Sparks RS. date 6/13/00 Existing System Inspection by: date

HEALTH DEPT. COPY: WHITE OWNER COPY (FINAL): YELLOW OWNER COPY (INITIAL): PINK