IREDELL COUNTY HEALTH DEPARTMENT

THE RANCH

STATESVILLE 704-878-5305 MOORESVILLE 704-664-5281

IMPROVEMENT PERMIT / AUTHORIZATION TO CONSTRUCT / OPERATION PERMIT / EXISTING SYSTEM INSPECTION

PERMIT# 123271 PIN# 4649 27 2322 DATE July 7, 05

OWNER OR CONTRACTOR Corinthian Dev. / Phil Sheppard PHONE: Business Home

ADDRESS P.O. Box 390 / Denver, NC. 28037

LOCATION Perth Rd (N) TR Fern Hill TL Carlyle 1st Lot on left

SUBDIVISION The Ranch BLOCK / SECTION 1 LOT 4 LOT AREA .66 Ac SITE CLASS PS DESIGN FLOW 360 gpd L.T.A.R. .25 Initial (Rear) .3 Repair (Front)

Septic Tank: 1000 Gallons; STB 786 Date 4/13/05
Pump Tank: 1000 Gallons; PT 32 Date 4/05
Pump Make: Gould's Model WE0511HH Serial No. G0581794
Nitrification Field: No Fields 1 Square Feet 480/720 Linear Feet 240
No Lines 3@80' Trench Width 24" w/18" cr Max Trench Bottom Depth 36" Gravel Depth NA

☒ New System ☐ Repair System Type: I, II, III, IV, V, VI
System Description: LPP PBPS
Repair System Description: LPP PBPS
Maintenance Agreement Required: ☒ Yes ☐ No

☒ House/Mod. Home No. Bedrooms 3
☐ Mobile Home No. Bathrooms
☐ Business No. Employees
☐ Other

☐ Slab ☒ Crawl Space ☐ Basement w/plumbing ☐ Basement wo/plumbing


Water Supply: ☒ Individual ☐ Public ☐ Community

Comments/Conditions: 24" = 36" max'd cr


Comments/Conditions:

INITIAL SITE SKETCH

1" = 50'

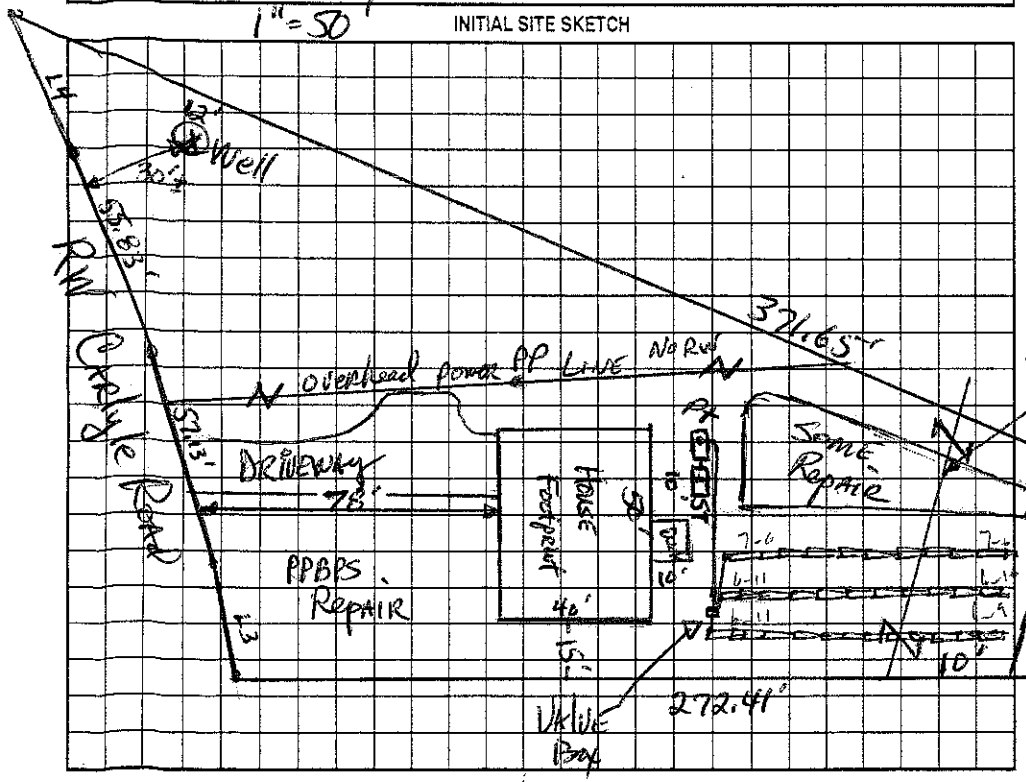

AS BUILT SKETCH

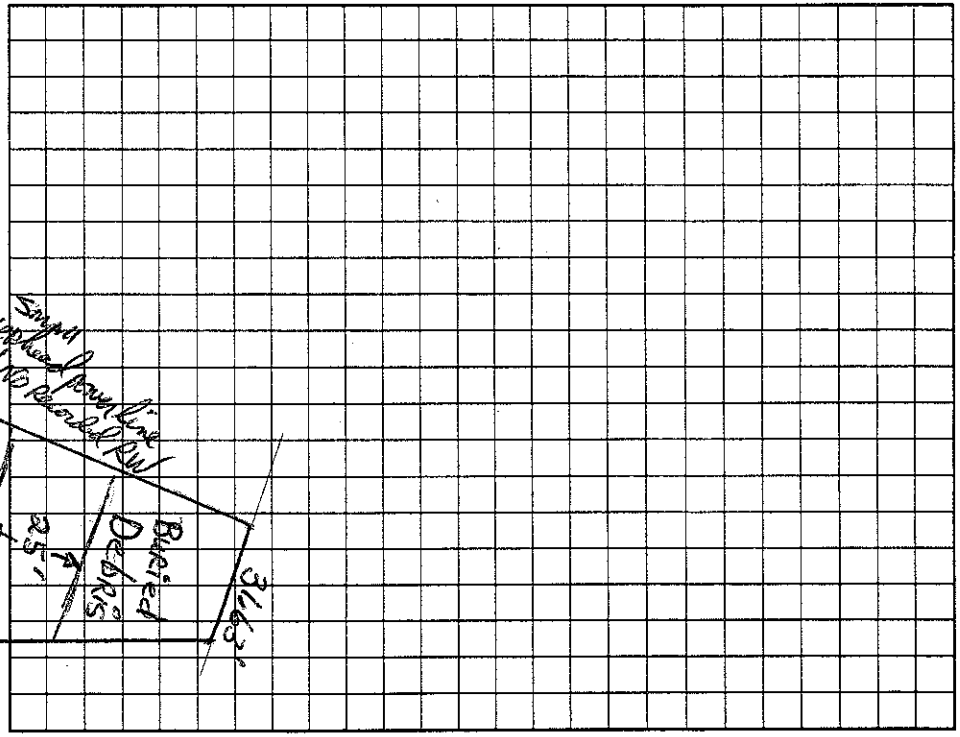

Permit can be suspended or revoked if any false information is supplied toward securing the permit/any unauthorized changes are made to the site/any unauthorized changes are made in the installation of the system. Improvement Permit with plat valid without expiration. Improvement Permit with site plan valid for sixty months. Authorization to Construct is valid for a period equal to that of Improvement Permit – not to exceed sixty months.

Signed: [signature] date 7/8/05 Installed by: CORINTHIAN DEVELOPERS

Improvement Permit by: [signature] date 7-7-05 Operation Permit by: [signature] date 10/26/05

Authorization to Construct by: [signature] date 7-8-05 Existing System Inspection by: date

HEALTH DEPT. COPY: WHITE OWNER COPY (FINAL): YELLOW OWNER COPY (INITIAL): PINK