IREDELL COUNTY HEALTH DEPARTMENT

Construction to Construct

STATESVILLE 704-878-5305 MOORESVILLE 704-664-5281

IMPROVEMENT PERMIT / ~~CERTIFICATE OF COMPLETION~~ / OPERATION PERMIT / EXISTING SYSTEM INSPECTION

PROPERTY DESCRIPTION NO. 24096 DATE 6/21/96 TAX MAP NO. 3F 6A 22 Watershed: X Yes ☐ No

OWNER OR CONTRACTOR Dick Gibbs PHONE: Business Home 528-3822

ADDRESS 117 Jasmine Cir Troutman, NC 28166 449-27-7957

LOCATION Caldwell Rd, TR Jasmine on (L) before intersection

SUBDIVISION King Acres BLOCK / SECTION LOT 22 LOT AREA SITE CLASS. DESIGN FLOW L.T.A.R.

Septic Tank: Existing Gallons; STB Date

Pump Tank: Gallons; PT Date

Pump Make: Model Serial No.

Nitrification Field: No Fields Existing System Linear Feet

No Lines Trench Width Max Trench Bottom Depth Gravel Depth

☐ New System ☐ Repair System Type: I (II) III, IV, V, VI

System Description: Existing System

Repair System Description:

Maintenance Agreement Required: ☐ Yes X No

☐ House/Mod. Home No. Bedrooms 3

X Mobile Home No. Bathrooms 2

☐ Business No. Employees

☐ Other

☐ Slab ☐ Crawl Space ☐ Basement w/plumbing ☐ Basement wo/plumbing


Water Supply:
☐ Individual
X Community
☐ Public

Comments: No

Comments: No record of system. No evidence of malfunction at this date

INITIAL SITE SKETCH

AS BUILT SKETCH

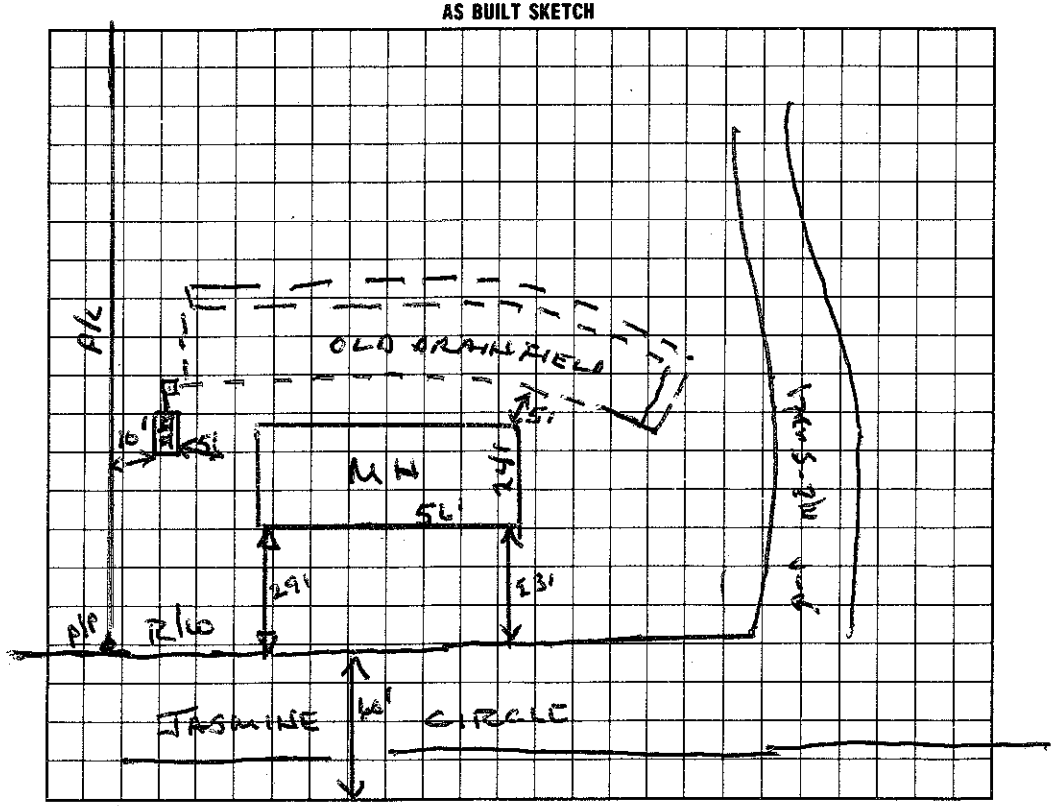

I understand that this permit can be suspended or revoked if any false information is supplied toward securing the permit/any unauthorized changes are made to the site/any unauthorized changes are made in the installation of the system.

Signed:

Improvement Permit by: date

Existing System Inspection by: date

Installed by:

~~Certificate of Completion by:~~ Existing System Wesley Sparks R.S. date 6/21/96

Operation Permit by: date

HEALTH DEPT. COPY: WHITE INSPECTION COPY (FINAL): GREEN OWNER COPY (FINAL): YELLOW INSPECTION COPY (INITIAL): PINK OWNER COPY (INITIAL): GOLD